DX 78-1


Ellis

KANSAS

Section 36 Township 13 Range 20W

Well No. #2 Engel "A"

Company Coppinger

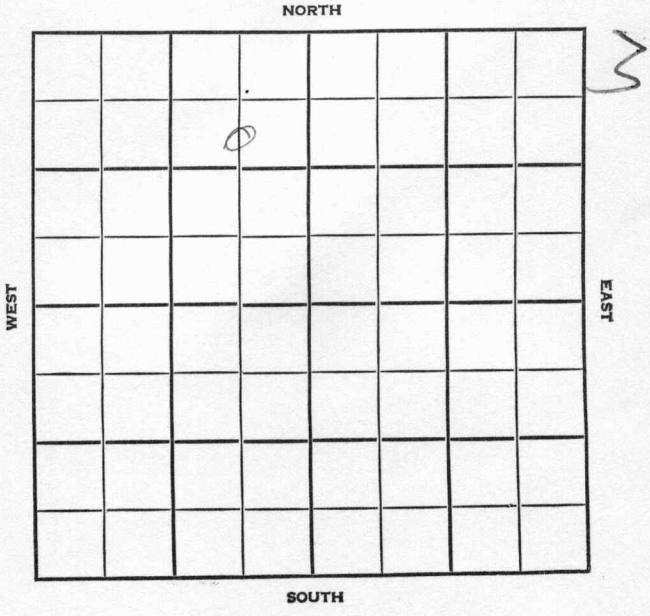

FORM 513 SUNRAY

County Ellis Elev.

Sec. 36 Twp. 13 Rge. 20W

Company Coppinger

Farm Name Engel "A" No. 2

TOPS	DEPTH	LOG	DATUM
Anh.			
Tp.			
H.			
Tr.			
Dg.			
B.L.			
L.			
K.C.			
B.K.C.			
Ce.			
C.			
M.			
M.			
K.			
Mz.			
Mc.			
V.			
S.			
S.			
A			
R.			
P€.			
G.			
T.D.			

Loc. in Sec. C S½ NE NW

Geol.

Contr. Co. tools

Pool Pleasant

FIRST REPORT

JAN 9 '57

Date Comm. 1-7-57

8" @ 216/125 WOC

Co. Lse. No. Sec. T. R.

FORM 513 SUNRAY

County Ellis Elev. 2222'

Sec. 36 Twp. 13 Rge. 20W

Company Coppinger

Farm Name Engel "A" No. 2

TOPS	DEPTH	LOG	DATUM
Anh.	1520		
Tp.			
H.	3474		
Tr.	3497		
Dg.			
Bl.			
L.	3517		
K.C.			
B.K.C.	3780		
Ce.			
C.	3832		
M.			
M.			
K.			
Mz.			
Mo.			
V.			
S.			
S.			
A	3864		
R.			
Pe.			
G.			
T.D.	3866		

Loc. in Sec. C S½ NE NW

Geol.

Contr. Co. tools

Pool Pleasant N

MAR 27 '57

COMPLETE

Date Comm. 1-7-57

8" @ 216/125 WOC JAN 30 '57 Ø3135

JAN 28 '57 DST 3860-66 90" rec 40'

Free oil +60' mdy oil 1110/30

5½ 3864½/100 JAN 30 '57 CO 3866

& 22 Goph 2 hrs no/w

DD 3868½ TD Ø 120 Go no/w

2 hrs Ø3¾ Bophr 8 hrs no/w

1000' O.B. FEB 6 '57 POP FEB 13 '57

FEB 20 '57 ✓ FEB 27 '57 MAR 6 '57 MAR 13 '57 MAR 20 '57

MAR 27 '57 Ph P. 119 Bopd no/wtr

Co. Lse. No. Sec. T. R.