


Section 36 Township 13 Range 20W

Well No. #1 Engel "B"

Company W. J. Coppinger

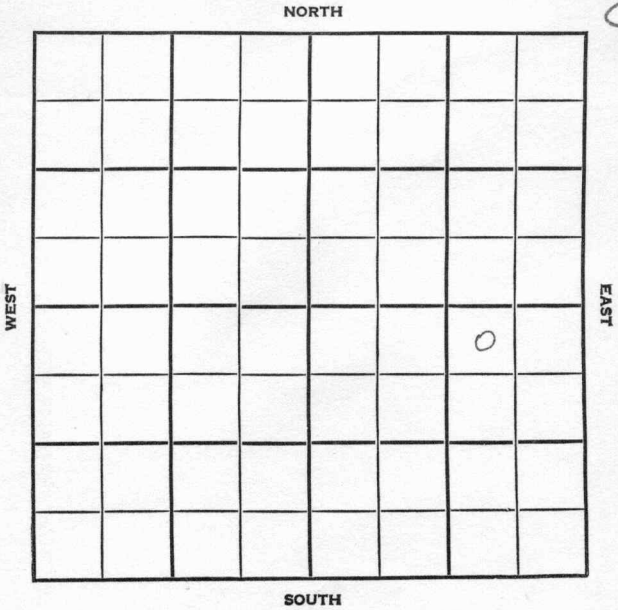

Ellis

KANSAS

SEC. 36

TWP. 13


R. 20W

WELL NO. #1 Engel "B" FARM

COMPANY W.J. Coppinger

CONTRACTOR Co. Tools Pleasant N.

_____ FT. FROM N. LINE
_____ FT. FROM S. LINE
_____ FT. FROM E. LINE
_____ FT. FROM W. LINE

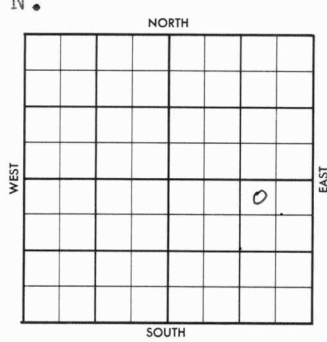

NW NE SE

1956 ELEVATION REPORT

8-29 Location

County Lewis Elev. 2235
 Sec. 20 Twp. 13 Rge. 20
 Company W. J. Coppinger
 Farm Name Engel "B" No. 1

TOPS	DEPTH	LOG	DATUM	Loc. in Sec.
Ans				NAME SE
TP				
H.	3492			
Tr.				
Dg.				
BL				
L.	3535			Geol.
K.C.				Contr
B.K.C.				
Ce.				Co. Tools
C.	3842			Pool Pleasant N.
M.				Pleasant
M.				
K.				
Mr.				
Me.				
V.				
S.				
S.				COMPLETE
A	rewrk 3861			
R	ARK 3876			
PE.				
G.				
T.D.	3588			

OCT 31 '56

Date Comm.

Location SEP 5 '56 ✓ SEP 12 '56 M/R SEP 19 '56

9-16-56 85/8 212/125

Ø 1500 SEP 26 '56 Ø 3550 OCT 2 '56

DST 3707-26 30" 5' Md (SSO)

BHP 130# DST 3842-76 ore

1hr 20' Md (SSO) + 1' Free oil

BHP 1065 DST 3870-80 1hr

90' GDS rec 35' HO & GCM + 120'

Mdy 955y oil BHP 1090 5 1/2 3876

CA

OCT 10 '56 CO 3880 \$ 2 1/4 Boph
1hr no lw \$ 1 Boph no time
150 acid \$ 2 Boph 1000' s.D

TFR OCT 17 '56 OCT 24 '56 OCT 31 '56

Ph. P. 244 Boph no lw
grain 42°

1956