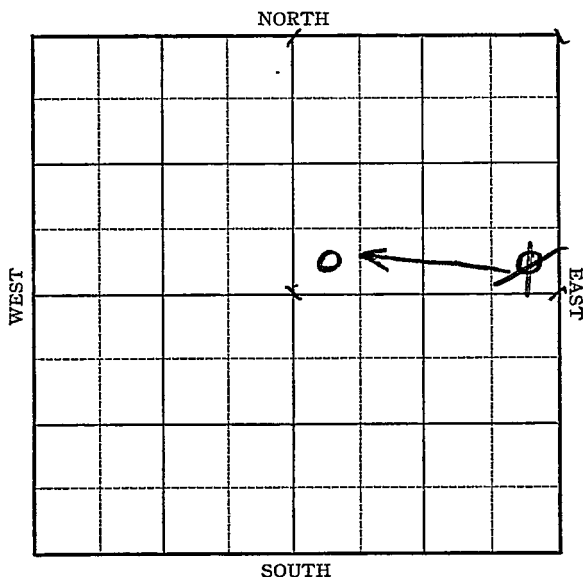



Rush

KANSAS

Section 23 Township 18 Range 16-WWell No. 2 CrowellCompany Morgan & Flynn

Sec. 23 Twp. 18 R. 16WWell No. #2 Crowell FarmMorgan & Flynn Company

SE NE

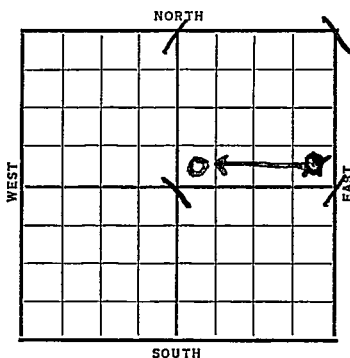 Ft. from N. Line330 Ft. from S. Line~~330~~ Ft. from E. Line330 Ft. from W. Line

Date	REPORT
1937	
8/25	Cellar
9/3	15" @ 207'. WOC.
9/10	10" @ 980'. WOC.
9/17	Drilg. 2715'.
9/24	Bosal sand 3500'.
	7" @ 3517'. RUST.
10/2	1st oil 3530'. T.D. 3554'.
	Flowed 258 B.O. with 43 M gas.
10/6	7" @ 3517'.
	Regan 3520'.
	T.D. 3554'.
	Potential 2205 oil.
	Est. 45 M gas.
	COMPLETED

Push KANSAS

Map No. _____ Sec. 23 Twp. 18 R. 16wWell No. 2. CrowellMorgan R. Flynn Company~~FIRST REPORT~~ Contractorsee ne

_____ Ft. from N. Line

330 Ft. from S. Line330 Ft. from E. Line

_____ Ft. from W. Line

SECTION PLAT

			0

Location _____

Rig up _____

Drilling and Remarks:

cellar

RECORD

Cased _____ in., _____ ft.

Sand _____

Gas _____

Oil _____

Total Depth _____

PRODUCTION

1st 24 hrs. Nat. _____

1st 24 hrs. after shot _____

Gas _____ Cu. Ft.

Dry Hole _____

Abandoned _____

Date

AUG 25 1937

19

H. D. Hatfield

Scout

Rush KANSAS

Map No. _____ Sec. 23 Twp. 18 R. 16 WWell No. 2 - CrowellMorgan & Flynn Company
Contractor

CORRECTION

SECTION PLAT

_____ Ft. from N. Line

330 Ft. from S. Line

_____ Ft. from E. Line

330 Ft. from W. Line

		0	

Location _____

Rig up _____

Drilling and Remarks:

*first reported
in semi
should be sure*

RECORD

Cased _____ in., _____ ft.

Sand _____

Gas _____

Oil _____

Total Depth _____

PRODUCTION

1st 24 hrs. Nat. _____

1st 24 hrs. after shot _____

Gas _____ Cu. Ft.

Dry Hole _____

Abandoned _____

Date

SEP 8 1937 19

H. B. Hatfield

Scout

Rush

KANSAS

Map No. 74 Sec. 23 Twp. 18 R. 16WWell No. 2 CrowellMorgan & Flynn Company

Contractor

COMPLETED

SW NE

 Ft. from N. Line330 Ft. from S. Line Ft. from E. Line330 Ft. from W. Line

SECTION PLAT

		0	

Location Rig up

Drilling and Remarks:

RECORD

Cased 7 in., 3517 ft.Sand Regan 3520Gas Oil Total Depth 3554

PRODUCTION

1st 24 hrs. Nat. 1st 24 hrs. after shot Gas Cu. Ft.Dry Hole Abandoned

Date

OCT - 6 1937 19E. D. Hatfield

Scout

POT- 2205 oil
EST. 45 M. gas