


Section 1 Township 13 Range 21 W

Well No. #2 Spilker "D"

Company Rex & Morris & CRA

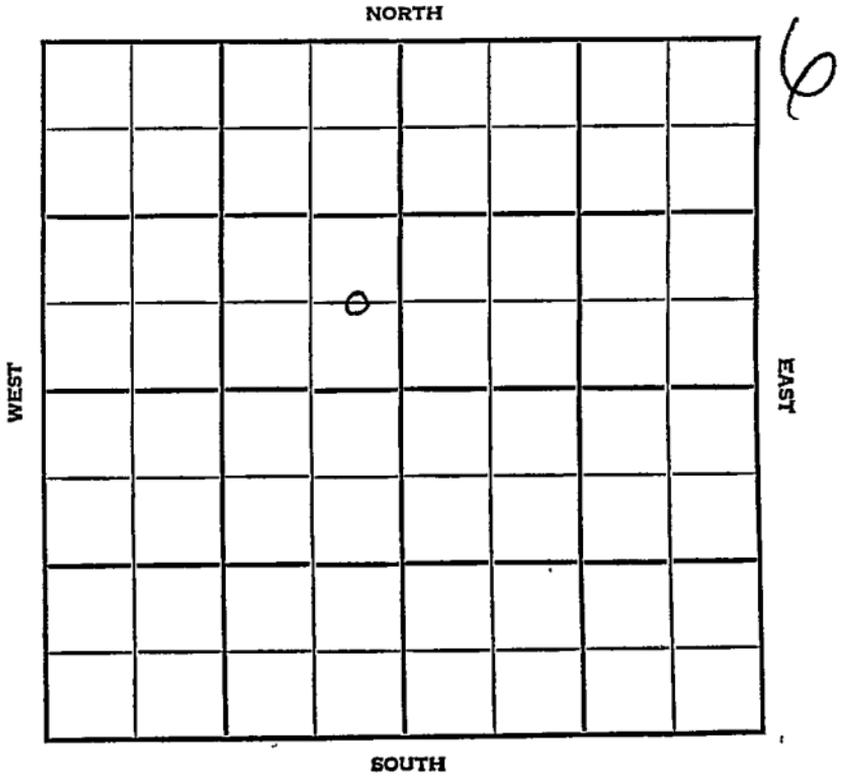

Trego

KANSAS

SEC.	TWP.	R.
1	13	21W

WELL NO.

#2 Spilker "D"

FARM

COMPANY

Rex & Morris & CRA

CONTRACTOR

Rex & Morris


Ellis

_____ Ft. from N. Line

_____ Ft. from S. Line

_____ Ft. from E. Line

_____ Ft. from W. Line

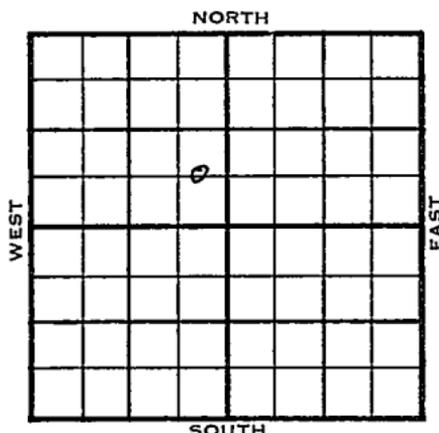~~Sec 13~~ C E $\frac{1}{2}$ SE NW

1955

ELEVATION

2163

REPORT

10/12 Loc

11-30

Comm. 10-21-55

8 5/8" @ 1510/750

DST 3736-66 op $\frac{1}{2}$ hr. rec. 5' ocm, 25' mud, 900/20"

DST 3795-3812 op 1 hr. rec. 20' ocm, 15' mud, 500/20"

DST 3811-27- op 1 hr. rec 420' gas, 135' oil 185' gco

5 1/2" @ 3835/125

CO to 3836

S/ 70 BO, 42 BW 5 hrs. :

FU 2000' fluid

P/ 51 BO, 52 BW 18 hrs.

P/ 26 1/2 Bo, 80 BW 21 hrs.

Comp. 55 BOPD, 90 BW

<u>Tops</u>	<u>Depth</u>	<u>Log</u>
Anh	1500	
H	3404	3405
Tr.	3424	3426
L.	3439	3442
BKC	3688	3690
Marm	3735	3735
A	3793	3793
R.	3834	3834
TD	3836'	

County Trego Elev. 2163
 Sec. 1 Twp. 13 Rge. 21W
 Company Rex & Morris & CRA
 Farm Name Spilker "D" No. 2

TOPS	DEPTH	LOG	DATUM	Loc. in Sec.
Anh.	<u>1500</u>			C E $\frac{1}{2}$ SE NW
Tp.				
H.	<u>3404</u>	<u>3405</u>	<u>1242</u>	
Tr.	<u>3424</u>	<u>3426</u>	<u>1263</u>	
Dg.				
Bl.				
L.	<u>3439</u>	<u>3442</u>	<u>1279</u>	
K.C.				Geol.
B.K.C.	<u>3688</u>	<u>3690</u>	<u>1527</u>	
Ce. <u>Manm</u>	<u>3735</u>	<u>3735</u>	<u>1572</u>	Contr.
C.				<u>Rex & Morris</u>
M.				
M.				
K.				Pool
Mz.				<u>Ellis</u>
Mq.				
V.				
S.				
S.				
A.	<u>3793</u>	<u>3793</u>	<u>1630</u>	
R.	<u>3834</u>	<u>3834</u>	<u>1671</u>	
PE.				
G.				
T.B.	<u>3836</u>			

COMPLETE

Date Comm. 10-21-55

NOV 30 1955

8 5/8" @ 1510/750 DST 3736-66 open

1/2 hr. rec. 5' ocm 25' mud 900/20"

DST 3795-3812 open 1 hr. rec. 20' ocm

15' mud 500/20" DST 3811-27 open 1 hr

rec. 120' gas 135' oil 185' gco

5 1/2" @ 3835/125 CO to 3836 S/ 70 bo

1/2 bw 5 hr. FU 2000' fluid P/ 51 bo

52 bw 18 hr. P/ 26 1/2 bo 80 bw 21 hr.

Comp. 55 bopd 90 bw