

Section 1 Township 13 Range 21 W

Well No. #1 Spilker "E"

Company Rex & Morris " CRA

NORTH

WEST

EAST

	0						

SOUTH

5

REG. SEC. 1	TWP 13	R. 21W
-------------	--------	--------


WELL NO. #1 Spilker "E" FARM

COMPANY Rex & Morris & CRA

CONTRACTOR Rex & Morris

S. Ellis

_____ Ft. from N. Line
 _____ Ft. from S. Line
 _____ Ft. from E. Line
 _____ Ft. from W. Line

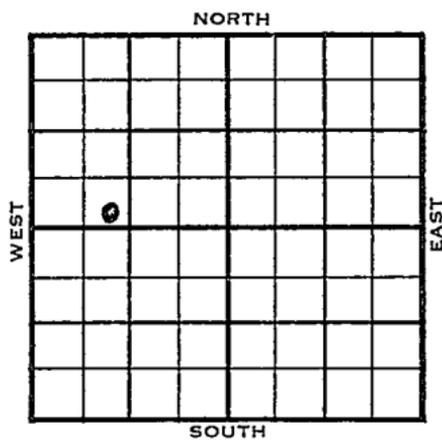

SE SW NW

1955	ELEVATION 2176'	REPORT
------	-----------------	--------

8/3 Location **FIRST REPORT**
 9-14 Comm. 8-5-55
 8 5/8" @ 1535 w/750 sx;
 DST 3814-36 op 1 hr. rec. 180' gas
 150' hm & geo, BHP 900# 20";
 DST 3836-56 op 1 hr. rec. 1950' wtr.
 BHP 1100# 20", Schlum.;
 5 1/2" 3856; w/100sx; CO 3837; 24/3814-
 20; bail 4 bo / sh of wtr. 3 1/2 hrs.;
 500 A; swb 145 bo 57 bw 7 hrs.;
 CO 3853; re-pf 24/3814-20; 250 A;
 bail 19.37 bo no wtr. 12 hrs.; pmp 60
 bo 10% bsw; pmp 25 bopd / 10% wtr.

<u>Tops</u>	<u>Depth</u>
Anh.	1525
H.	3418
Tr.	3440
L.	3455
B.K.C.	3702
Marm	3751
Congl.	3786
Fea	3812
Arb.	3821
Wh	3854

 T.D. 3856'

COMPLETED

County Trego Elev. _____
 Sec. 1 Twp. 13 Rge. 21W
 Company Rex & Morris & CRA
 FarmName Spilker "E" No. 1

TOPS	DEPTH	LOG	DATUM
Anh.			
Tp.			
H.			
Tr.			
Dg.			
Bl.			
L.			
K.C.			
B.K.C.			
Ce.			
C.			
M.			
M.			
K.			
Mz.			
Me.			
V.			
S.			
S.			
A.			
R.			
PE.			
G.			
T.D.			

Loc. in Sec. SE SW NW
 Geol. _____
 Contr. Rex & Morris
 Pool S. Ellis

FIRST REPORT
 0
 AUG 3 '55

Date Comm. _____
 Location _____

15

Co.
 Lse.
 No.
 Sec.
 T.
 R.

County Trego Elev. 2176
 Sec. 1 Twp. 13S Rge. 21W
 Company Rex & Morris & C.R.A.
 Farm Name Spilker "E" No. 1

TOPS	DEPTH	LOG	DATUM	Loc. in Sec.
Anh.	1525			SE SW NW
Tr.				
H.	3418		1242	
Tr.	3440		1264	
Dg.				
Bl.				
L.	3455		1279	Geol.
K.C.				Contr.
B.K.C.	3702		1526	Rex & Morris
Ce.				Pool
C.				Ellis
M. Congl.	3757		1575	
M.	3786		1610	
K.				
Mz.				
Me.				
V.				
S.				
S.				
A. Wea.	3812		1636	COMPLETE
Arb.	3821		1645	
Pe.				
G. Wh	3854		1678	
T.D.	3856			

Date Comm. 8-5-55 SEP 14 1955

8-5/8" 1535 w/750 sx; DST 3814-36 op
 1 hr. rec. 180' gas 150' hm & gco, BHP 900#
 20"; DST 3836-56 op 1 hr. rec. 1950' wtr.
 BHP 1100# 20"; Schlum.; 5 1/2" 3856; w/100 sx;
 CO 3837; 24/3814-20; bail 4 bo / sh of wtr.
 3 1/2 hrs.; 500 A; swb 145 bo 57 bw 7 hrs.;
 CO 3853; re-pf 24/3814-20; 250 A; bail
 19.37 bo no wtr. 12 hrs.; pmp 60 bo 10%
 bsw; pmp 25 bopd / 10% wtr.