


SECTION 32 TOWNSHIP 15 RANGE 14W

WELL NO. #2 Nuss

COMPANY Rudy Herman

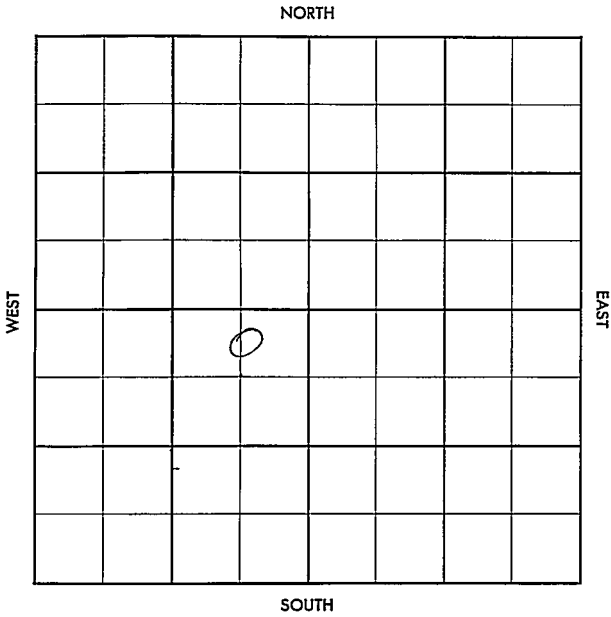

1956

7-25continued

P/ 50 BOPD, no/wtr.

P/ 220 BOPD ~~4~~ tr. wtr.

Tp. 2818'; H. 3046'; Tr. 3064';

L. 3108'; A. 3355';

TD 3360'

COMPLETED

County Russell Elev. _____
 Sec. 32 Twp. 15 Rge. 14W
 Company Rudy Herman
 FarmName Nuss No. 2

TOPS	DEPTH	LOG	DATUM
Anh.			
Tp.			
H.			
Tr.			
Dg.			
Bl.			
L.			
K.C.			
B.K.C.			
Ce.			
C.			
M.			
M.			
K.			
Mz.			
Me.			
V.			
S.			
S.			
A.			
R.			
PE.			
G.			
T.D.			

Loc. in Sec. C N $\frac{1}{2}$ NE SW

Geol. _____
 Contr. Trans-Era

Pool Nuss

FIRST REPORT
 MAY 23 '36

Date Comm. M I R

2001 P S YARD

Co.
 Use.
 No.
 Sec.
 T.
 R.

Co.

County Russell Elev. 1901
 Sec. 32 Twp. 15 Rge. 14W
 Company Rudy Herman
 Farm Name Nuss No. 2

TOPS	DEPTH	LOG	DATUM	Loc. in Sec.
Anb.				C N $\frac{1}{2}$ NE SW
TP	2818			800 EL
H.	3066			
Tr.	3064			
Dg.				
Bl.				
L.	3108			Geol. _____
K.C.				Contr. _____
B.K.C.				Trans-Era
Ce.				Pool
C.				Nuss
M.				COMPLETE
M.				
K.				
Mz.				
Ma.				
V.				
S.				
S.	3355			
A.				
R.				
PE.				
G.				
TD.	3360			JUL 25 1956

Lse.

No.

Sec.

T.

R.

Date Comm. M I R MAY 29 56 5-22-56

85/8 315 M 3211 JUN 6 '56
DST 3078 - 3120 (60) 923 (45)
FLC 2160' o.l. FP 240-260
BHP 850 (20) DST 3140-50 (60)
255' o.l. BHP 630 (20) DST 3140
3211 (60) 1500 GIP rel 300' M OVI
1 30' wtz 840 (20)
TD 3360 5 1/2 3357
DD 3377

32-15-1400

N/2 NE 30

plug @ 3350

18/3338-

\$ 4 BOPH NW 1000 A

\$ 4 BOPH NW plug @ 3335

pf 12/3322-29 1000 A \$/h

CO. 3350 \$ 10 BOPH NW / 360

PB 3310 pf 24/3283-87

JUN 12 '58 \$ 5 BOPH 80% wtr PB 3235

pf 18/3204-07 1500 A \$ 50 BF

50% wtr PB 3160 pf 30/3111-16

\$ 500 \$ 50 BO NW POP

P 200 BOPD + 757 JUN 20 '56

Ph P. 200 Bopd + Trace

wtr JUN 27 '56 P. 50 Bopd no wtr

JUL 3 '56 JUL 11 '56 JUL 18 '56 JUL 25 '56 Ph P.

220 Bopd + Tr. wtr.