


Russell

KANSAS

SECTION 32 TOWNSHIP 15 RANGE 14 WWELL NO. #1 Nuss "S"COMPANY Rudy Herman

NORTH

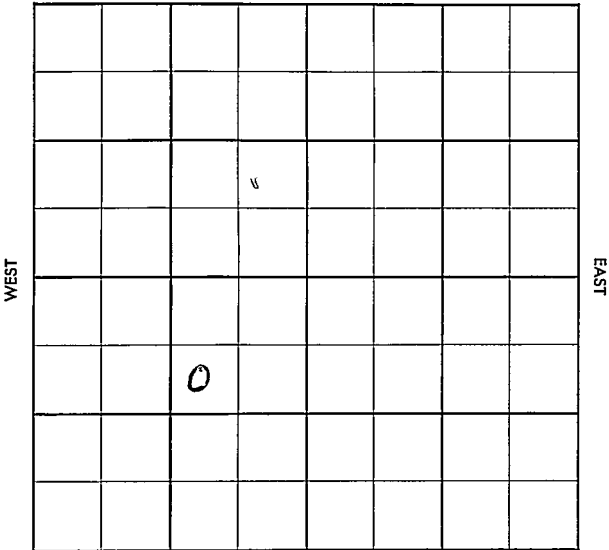

SOUTH

Russell

KANSAS

SEC. 32	TWP. 15	R. 14W
------------	------------	-----------

WELL NO.

#1 Nuss

FARM

COMPANY

Rudy Herman

CONTRACTOR

Welch & Olsson


_____ Ft. from N. Line

_____ Ft. from S. Line

_____ Ft. from E. Line

_____ Ft. from W. Line

SW NE SW

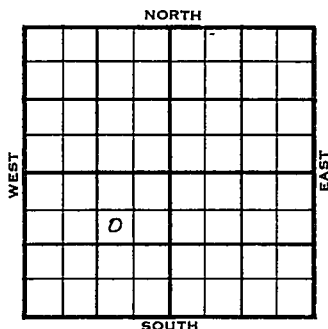

	ELEVATION	REPORT
1955	1879'	
11-23	Pipe set No dope	
<u>1956</u>		
1-18	Comm. 11-12-55 8 5/8" @ 307/200 DST 3123-33 op 1/2 hr. rec. 30' muddy # gassy oil, 165' gassy oil, 15' wtr. 840/20" DST 3338-52 op 1/2 hr. rec. 5' mud, 25/15" 5 1/2" @ 3352/15" CO perf. 3121-24 B/ 1 goph, 1000 A S/ 7 boph, Comp. 270 bopd 2% wtr. Log tops: Anh. 783 H. 3023 Tr. 3047 L. 3090 BKC 3299 A. 3337 TD 3352'	
		COMPLETED

County Russell Elev. 114W
 Sec. 32 Twp. 15 Rge. 11W
 Company Rudy Herman
 Farm Name Miss No. 1

Co.

F

No.

Sec.

T.

R.

TOPS

DEPTH

LOG

DATUM

Loc. in Sec.

Anb. SW NE SWTp. H. Tr. Dg. Bl. L. K.C. B.K.C. Ce. C. M. M. K. Mz. Mq. V. S. S. A. R. P.E. G. T.D. Geol. Contr. Welch & OlssonPool

FIRST REPORT

NOV 23 '55

Date Comm.

Pipe set

No dope

27

County Russell Elev. 1879 Co. 5
 Sec. 32 Twp. 15 Rge. 14W
 Company Rudy Herman
 Farm Name "Nuss" "B" No. 1

TOPS	DEPTH	LOG	DATUM	Loc. in Sec.
Ank.	783			SW NE SW
TP.				
H.	3028			
Tr.	3047			
Dg.				
BL.				
L.	3090		1211	Geol.
K.C.				Contr.
B.K.C.	3299		1420	Welch & Olson
Ce.				Pool
C.				Nuss
M.				
M.				
K.				
Mz.				
Me.				
V.				
S.				
S.				
A.	3337		1458	
R.				
Pe.				
G.				
TD.	3352			

Date Comm. 11-12-55 JAN 1 8 1956
8 5/8" @ 307/200 DST 3123-33

open $\frac{1}{2}$ hr. rec. 30' muddy gassy oil
 165' gassy oil 15' wtr. 840/20"
 DST 3338-52 open $\frac{1}{2}$ hr. rec. 5' mud
 25/15" 5 $\frac{1}{2}$ " @ 3352/15" CO perf. 3121-
 24 B/ 1 goph 1000 A S/ 7 boph
 Comp. 270 bopd 2% wtr.