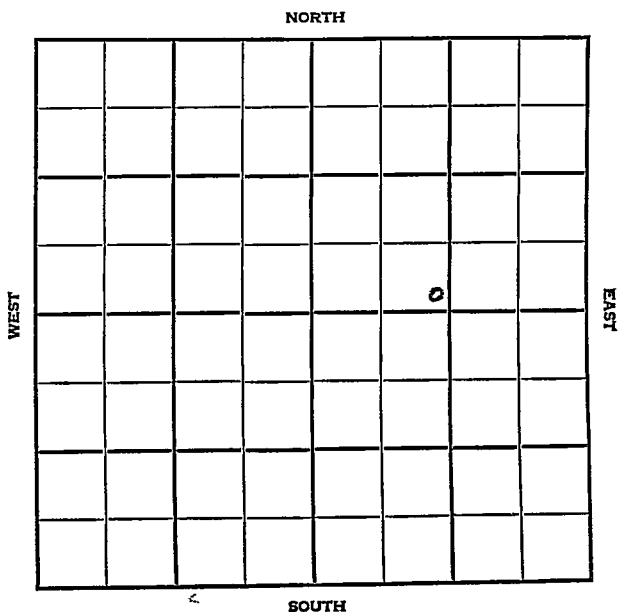


Section 1 Township 13 Range 21WWell No. #5 A. I. CrombCompany Stanolind

WELL NO.

FARM

**COMPANY**

## Stanolind

**CONTRACTOR**

Ellis

Ft. from N. Line

Ft. from S. Line

Ft. from E. Line

Ft. from W. Line

SE SW NE

NORTH

**WEST**

# EAST

**SOUTH**

### ELEVATION

2176

## REPORT

1055

6/1

Comm 5-10-55

8<sup>n</sup> @ 207/150 DST 3660-73 open 1 hr.

Rec. 3' socm 855/20" cored 3799-3804

Rec. 4' DST 3792-3804 failed BST

3793-3804 open 1 hr. Rec. 3' mud 0#

DST 3818-25 open 1 hr. Rec. 2' ocm

1' oil 35/20" DST 3825-80 open 1 hr.

Rec. 250' mud 2100' ocs w 1130/20"

DST 3814-22 open 1 hr. Rec. 20' socm

390/20<sup>n</sup> D&A

**TOPS**

| DEPTH | LOG | DATUM |
|-------|-----|-------|
|-------|-----|-------|

Anh. 1518 1520

|    |      |      |      |
|----|------|------|------|
| H. | 3415 | 3412 | 1236 |
|----|------|------|------|

|     |      |      |
|-----|------|------|
| Tr. | 3433 | 1257 |
|-----|------|------|

|    |      |      |
|----|------|------|
| L. | 3449 | 1273 |
|----|------|------|

K.C. 3452 1276

|       |      |      |
|-------|------|------|
| Marm. | 3742 | 1566 |
|-------|------|------|

|    |      |      |
|----|------|------|
| A. | 3814 | 1638 |
|----|------|------|

R. 3852 1676

Pf. 3872 1696

TD. 3880

# FIRST REPORT

**ABANDONED**

County Trego Elev. 2176  
 Sec. 1 Twp. 13 Rge. 21W  
 Company Stanolind  
 Farm Name A. I. Eromb No. 5

| TOPS            | DEPTH | LOG  | DATUM | Loc. in Sec. |
|-----------------|-------|------|-------|--------------|
| Anh.            | 1518  | 1520 |       | SE SW NE     |
| TP.             |       |      |       |              |
| H.              | 3415  | 3412 | 1236  |              |
| Tr.             |       | 3433 | 1257  |              |
| Dg.             |       |      |       | Geol.        |
| BL.             |       |      |       |              |
| L.              |       | 3449 | 1273  |              |
| K.C.            | 3452  |      | 1276  |              |
| B.K.C.          |       |      |       | Contr.       |
| Gr. <u>Marm</u> |       | 3742 | 1566  |              |
| C.              |       |      |       |              |
| M.              |       |      |       |              |
| M.              |       |      |       | Pool         |
| K.              |       |      |       |              |
| Mz.             |       |      |       |              |
| Me.             |       |      |       |              |
| V.              |       |      |       | Ellis        |
| S.              |       |      |       |              |
| S.              |       |      |       |              |
| A               |       | 3814 | 1638  |              |
| R.              |       | 3852 | 1676  | FIRST REPORT |
| PE.             |       | 3872 | 1696  |              |
| G.              |       |      |       |              |
|                 |       |      |       |              |
| T.D.            | 3880  |      |       | ABANDONED    |
|                 |       |      |       |              |
|                 |       |      |       |              |
|                 |       |      |       |              |

Date Comm. 5-10-55 JUN 1 1955  
 8" @ 207/150 DST 3660-73 open 1 hr.  
 Rec. 3' socm 855/20" cored 3799-3804  
 Rec. 4' DST 3792-3804 failed  
 DST 3793-3804 open 1 hr. Rec. 3' mud  
 O# DST 3818-25 open 1 hr. Rec. 2' ocm  
 1' oil 35/20" DST 3825-80 open 1 hr.  
 Rec. 250' mud 2100' ocs w 1130/20"  
 DST 3814-22 open 1 hr. Rec. 20' socm  
 390/20" D & A