

KANSAS


Trego

FORM 51 5M 1-42 PETROL

Section 1 Township 13 Range 21-W

Well No. # 2 Cromb

Company Stanolind

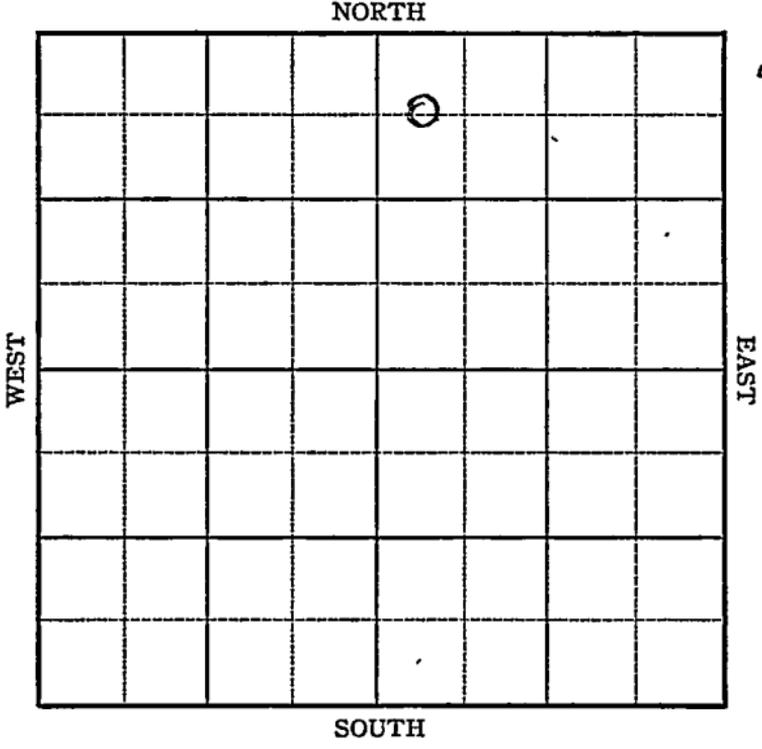


Sec. 1 Twp. 13 R. 21-W

Well No. #2 Cromb Farm

Stanolind Company

NORTH

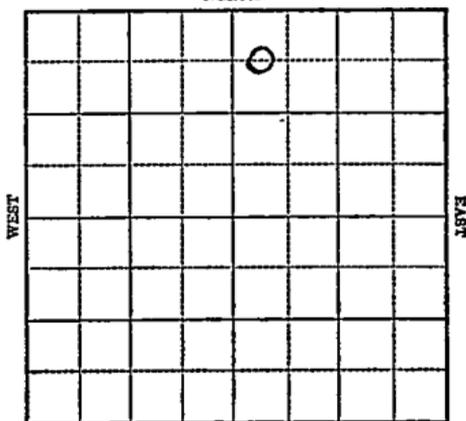

660 Ft. from N. Line

_____ Ft. from S. Line

_____ Ft. from E. Line

330 Ft. from W. Line

Elev. 2180

1943 R E P O R T

11/24	Derrick
12/1	"
12/8	18" @ 117 Drlg. 976'
12-15	8" at 1195' Anhy 1524' Drlg. 2434'
12/22	3140 fsg.
12/29	Topeka 3193 Lans 3455 Coring 3819'
1944	
1-5	Arb 3821-23 TD 5" @ 3820 Rust VSSO
1-12	TD 3848 swb 60 oil in 24 hrs. 2000 acid.
1/19	Swab 9 oil in 5 hrs.
1/26	" " "
2/2	" " "
2/8	5" @ 3820 Arb 3821 TD 3848 2000 acid Pump 120 Pot. Gravity 36

COMPLETED

Trego

Map No. 70 Sec. 1 Twp. 13 R. 21W

Well No. 2 Cromb

Stanolind Company

FIRST REPORT

Contractor

C W L NW NE

SECTION PLAT

660 Ft. from N. Line

_____ Ft. from S. Line

_____ Ft. from E. Line

330 Ft. from W. Line

Ellis Pool

Location _____

Rig up _____

Drilling and Remarks:

Derrick

RECORD

Cased _____ in., _____ ft.

Sand _____

Gas _____

Oil _____

Total Depth _____

PRODUCTION

1st 24 hrs. Nat. _____

1st 24 hrs. after shot _____

Gas _____ Cu. Ft.

Dry Hole _____

Abandoned _____

Date

NOV 24 1943 19

S. J. LEWIS Scout

KANSAS

Map No. 70 Sec. 1 Twp. 13 R. 21 N

Well No. 2 Cromb

Stanolind Company

COMPLETED Contractor

C W L NW NE

SECTION PLAT

660 Ft. from N. Line

_____ Ft. from S. Line

_____ Ft. from E. Line

330 Ft. from W. Line

		o	

Ellis Pool

Location _____

Rig up _____

Drilling and Remarks:

Cor & 3821
5" @ 3820
2000 acid
Pump 120 P & X
360 G

RECORD

Cased _____ in., _____ ft.

Sand _____

Gas _____

Oil _____

Total Depth 3848

PRODUCTION

1st 24 hrs. Nat. _____

1st 24 hrs. after shot _____

Gas _____ Cu. Ft.

Dry Hole _____

Abandoned _____

Date

FFR 9 1944 19

S. J. LEWIS Scout