

Trego

Sec. 2 Twp. 13 R. 21 W

Well No. # 1 Deutscher Farm

Stanolind Company

Transit Drlg. Contractor

Wildcat


990 Ft. from N. Line

_____ Ft. from S. Line

330 Ft. from E. Line

_____ Ft. from W. Line

SE NE NE

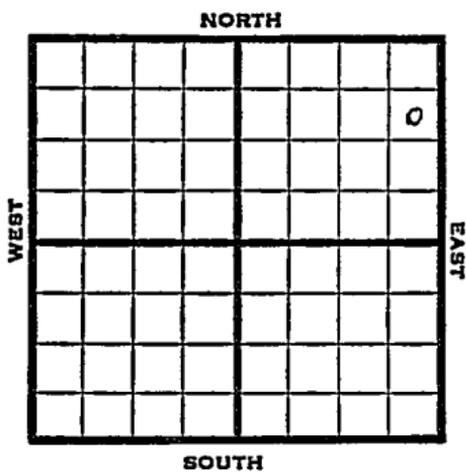

1951 Elev. 2185' REPORT

10/10 Location

11/11 Spud 10-17-51
 D & A TD 3913' 10" @ 122'
 Top. 3192'
 DST 3232-39 open 1 hr. rec 15' mud.
 Lans. 3468' Arb. 3858'
 DST 3848-60 open 1 hr. rec 4' mud & SSO
 DST 3858-72 open 20 min. rec 630' water
 Granite 3905'
 DST 3875-82 open 20 min. rec 1085' SW
 TD 3913' D & A

ABANDONED

