

Section 34 Township 15 Range 11W

Well No. #1 ~~Grad~~ FIELDS

Company ~~B & R Oils~~ NCRH

NORTH

WEST

EAST

0							

SOUTH

Russell

Sec. 34 Twp. 15 R. 11W

Well No. #1 ~~Grad~~ Fields Farm

NCR A
B & R Drlg. Company

Contractor

Ft. from N. Line

990


Ft. from S. Line

Ft. from E. Line

330

Ft. from W. Line

NW SW SW

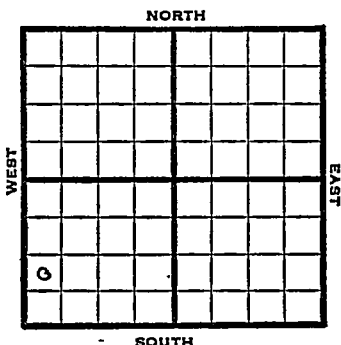

1952

Elev. 1884' REPORT

- 3/5 Spud 3-1-52
Drlg.
- 3/11 8" @ 220'
Drlg. 1150'
- 3/19 Heeb. 3048 Lans. 3107
DST 3144-55 1½ hr.
300' SW 850# Drlg. 3175
- 3/25 DST 3270-08, 2 hrs. 130' V HOCM
& MCO 3' oil 990# BKG 3316
DST 3314-35, 2 hrs. 20' m O#
Arb. 3349 RTD 3350
Sch. 5" @ 3349 WOCT
- 4/1 RUST CO to 3350 DD to 3367
B 3 to 4 BWPB for 3 hrs. PB 3349
8/ 3344-46 4/ 3339-40 NS
16/ 3340-44 500 A set plug
- 4/9 B/4 gal oil 15 hrs. PB 3308
24/3275-81 B/1 gal oil 1 hr 500A
S/1½ boph 1500 A S/5 Boph for 4 hrs.
S/28 & trace wtr 9 hrs.
- 4/23 POP
- 4/30 "

OVER

KANSAS

Map No. _____ Sec. 34 Twp. 15 R. 14W

Well No. 1 Fields

N C R A

Company

~~CORRECTION~~

Contractor

NW SW SW

SECTION PLAT

0			

_____ Ft. from N. Line

990 Ft. from S. Line

_____ Ft. from E. Line

330 Ft. from W. Line

Russell County

Location _____

Rig up _____

Drilling and Remarks:

Reported

B & R Drlg.

#1 Grad

RECORD

Cased _____ in., _____ ft.

Sand _____

Gas _____

Oil _____

Total Depth _____

PRODUCTION

1st 24 hrs. Nat. _____

1st 24 hrs. after shot _____

Gas _____ Cu. Ft.

Dry Hole _____

Abandoned _____

Date

MAR 12 1952 19

J. G. McGEHEE

Scout

1952
5/7

Spud 3-1-52
Oil well TD 3350' 8" @ 220
Heeb 3048' Lans. 3107'
DST 3144-55 open $1\frac{1}{2}$ hr. rec 300' SW
DST 3270-3308 open 2 hr, rec 130' VHO
CM & MCO 3' oil
B KC 3316'
DST 3314-35 open 2 hr, rec 20' mud
Arb. 3349' TD 3350 5" @ 3349
GO to 3350 DD 3367 B/3 to 4 BWPH
PB 3349' 8/3344-46 4/3339-40
16/3340-44 500 A B/4 GO 15 hr.
PB 3308' 24/3275-81 B/1 GOPH
500 A S/ $1\frac{1}{2}$ BOPH 1500 A
S/5 BOPH 4 hr. S/28 BO 9 hr.
Comp. $14\frac{1}{2}$ BOPD $21\frac{1}{2}$ BW

COMPLETED