

Section 34 Township 15 Range 14 WWell No. # 4 Schneider "C"Company Aladdin Petroleum

NORTH

WEST

EAST

					0		

SOUTH

Russell

KANSAS

SEC.	TWP.	R.
34	15	14 W

WELL NO.

4 Schneider "C"

FARM

COMPANY

Aladdin Petroleum

CONTRACTOR

Lewis Drlg. Co.

Trapp Pool


990 Ft. from N. Line

Ft. from S. Line

Ft. from E. Line

990 Ft. from W. Line


SE NW NE

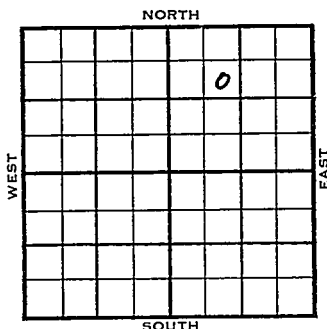

1954	ELEVATION 1900'	REPORT
9/22	Spud 9-17-54 8" @ 273' Anhy 905' Drlg. 976'	
11/3	Spud 9-17-54 SWD Well TD 3420' 8" @ 273' Anhy 905', Lans 3105', Arb 3345' TD 3420' 5" @ 3420' CO to 3350 24/ 3343-49 HFW 120 bwph CO to 3416 PB 3387 12/ 3354-56 18/ 3359-62 125 A 2 bwph SP 3350 18/ 3343-49 7 bwph CO to 3416 318/ 3362-3416 7500 A Comp for SWD Well 120 bwph.	
ABANDONED		

FABEN GILSTRAP

County Russell State Kansas
 Sec. 34 (Blk.) 15 (Sur.) 14W Map No.
 Operator Aladdin Petroleum
 Well No. 4 Farm Schneider "C"
 Elev. 1900 Location SE NW NE

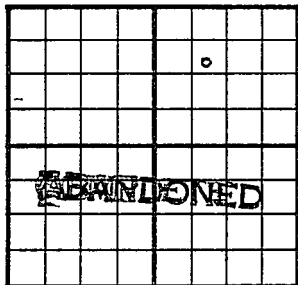

990 Ft. From N Line NE
 990 Ft. From W Line Quarter
 Ist. Report
 Completion NOV 3 1954
 Remarks Trapp Pool
Lewis Drlg. - Contr.
 Spudding Date 9-17-54

Drlg. Data SWD well TD 3420
8" @ 273 Anhy 905 Lans. 3105
Arb. 3345 TD 3420 5" @ 3420 CO to
3350 24/ 3343-49 HFW 120 bwph
CO to 3416 PB 3387 12/ 3354-56
18/ 3359-62 125 A 2 bwph SP 3350
18/ 3343-49 7 bwph CO to 3416
318/ 3362-3416 7500 A
Comp. for SWD well 120 bwph

FABEN GILSTRAP