


Section 34 Township 15 Range 14 W

Well No. # 1 Strecker

Company Morris Sitrin

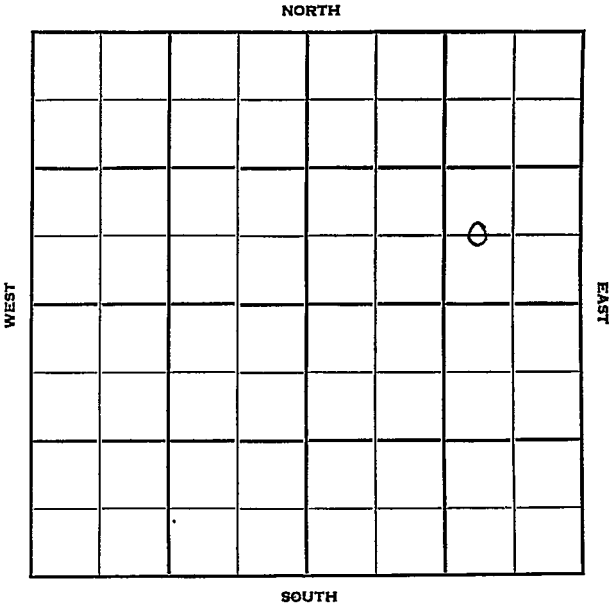

Russell

KANSAS

Sec. 34 Twp. 15 R. 14 W

Well No. # 1 Strecker Farm

Morris Sitrin Company

Trapp Pool Contractor


         Ft. from N. Line

660 Ft. from S. Line

990 Ft. from E. Line

         Ft. from W. Line

C WL SE NE

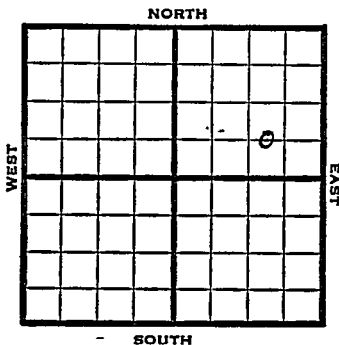

1951 Elev. 1914' REPORT

9/19 8" @ 154' Anhy 918'  
Drlg. 2140'

10/31 Spud 9-12-51  
Oil Well TD 3367  
8" @ 154  
Anhy 918 Heeb. 3057  
Lans. 3120  
DST 3182-3207 open 20 min.  
Rec. 8' mud  
DST 3276-3305 open 1/2 hr.  
Rec. 8' mud  
Arb. 3355-57  
5" @ 3356 TD 3367  
5 GOPH 2000 A S/ 5 BOPH  
Comp. 50 BOPD

**COMPLETED**

County Russell State Kansas

Sec. 34 (Blk. Twp.) 15 (Sur. Rge.) 14W Map No.

Operator Morris Sitrin

Well No. 1 Farm Strecker

Elev. Location C W L SE NE


660 Ft. From S Line NE

990 Ft. From E Line Quarter

1st. Report SEP 19 1951

Completion \_\_\_\_\_

Remarks \_\_\_\_\_

Spudding Date \_\_\_\_\_

Drig. Data Trapp Pool

Location 8" c 154 Anhy 918

drig. 3140

