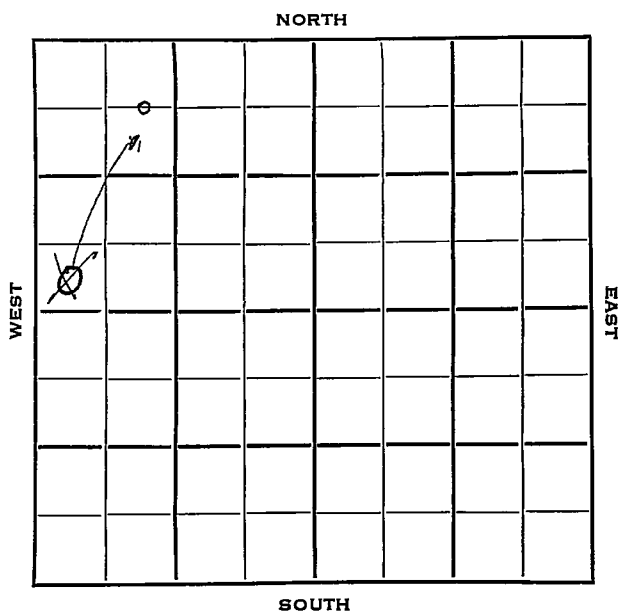


Section 25 Township 34 Range 3EWell No. #1 Land & PowerCompany Martin & Gash

Cowley KANSAS ✓

Sec. 25 Twp. 34 R. 3E

Well No. #1 Land & Power Farm

Martin & Cash Company

Martin & Cash Contractor

2050 Ft. from N. Line


330 Ft. from S. Line

800 Ft. from E. Line

330 Ft. from W. Line

~~SW SW NW~~

CEL NW NW

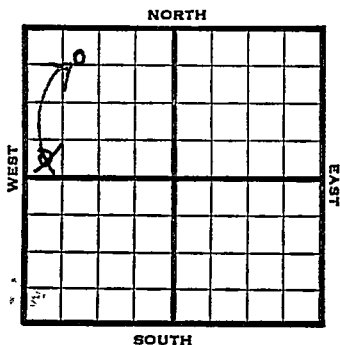

1953 Elev. 1081' REPORT

5/6 Drlg.

5/27 Spud 5-3-53
D&A
TD 3331
8" @ 100
Stal. 2120, Layton 2520, KC 2740,
Bart 3252
TD 3331
D&A

ABANDONED

County Cowley State Kansas

Sec. 25 (Blk. 34 (Sur. 3E Map No. 3E)
(Twp.) (Rge.)

Operator Martin & Cash

Well No. 1 Farm Land & Power

Elev. _____ Location SW SSWW

0					

FIRST REPORT

330 Ft. From S Line NW

330 Ft. From W Line Quarter

1st. Report MAY 6 1953

Completion _____

Remarks _____

Martin & Cash - Contr.

Spudding Date _____

Drlg. Data _____

drlg.

J. G. McGEHEE

Map No. _____ Sec. 25 Twp. 34 R. 3EWell No. 1 Land & Power __________Martin & Cash_____ Company_____CORRECTION_____ Contractor

C E L NW NW

SECTION PLAT

_____ Ft. from N. Line

2050 Ft. from S. Line

_____ Ft. from E. Line

800 Ft. from W. Line

o			

Cowley County

Location _____

Rig up _____

Drilling and Remarks: _____

Reported
SW SW NW

RECORD

Cased _____ in., _____ ft.

Sand _____

Gas _____

Oil _____

Total Depth _____

PRODUCTION

1st 24 hrs. Nat. _____

1st 24 hrs. after shot _____

Gas _____ Cu. Ft.

Dry Hole _____

Abandoned _____


Date

MAY 27 1953

19

J. G. McGEHEE

Scout

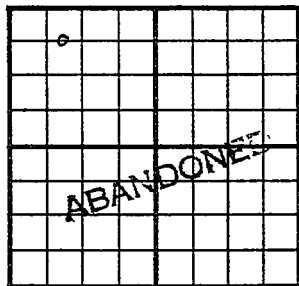County Cowley State KansasSec. 25 (Blk. 34 Twp.) (Sur. 3E Rge.) Map No. Operator Martin & CashWell No. 1 Farm Land & PowerElev. 1081 Location C E L NW NW2050 Ft. From S Line NW800 Ft. From W Line Quarter1st. Report Completion MAY 27 1953Remarks Martin & Cash - Contr.Spudding Date 5-3-53Drilg. Data D & A TD 33318" @ 100 Stal. 2120 Layton 2520KC 2740 Bart. 3252 TD 3331D & A