

Section 28 Township 3 4 Range E

Well No. #2 Baird

Company Gross Drlg.

NORTH

WEST

EAST

0							

SOUTH

KANSAS

TWP.

R.

28

34

3E

WELL NO.

#2 Baird

FARM

COMPANY

Gross Drlg.

CONTRACTOR

Gibson Ext.

NORTH

Ft. from N. Line

330


Ft. from S. Line

Ft. from E. Line

330

Ft. from W. Line

SW SW SW

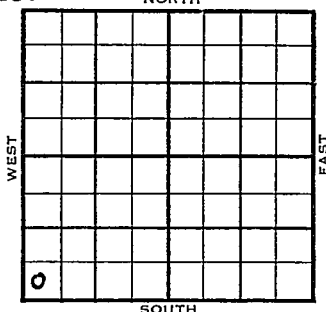

ELEVATION

REPORT

1954

1138:

2/17

Cellar & Pits.

4/21

Spud 3-31-54

D & A

TD 3439

8" @ 103'

Layton 2663', KC 2865', Cleveland

2985', Oswego 3062', Cherokee 3183'

Bart 3358' Miss 3400'

TD 3439'

D & A

ABANDONED

County **Cowley** State **Kansas**

Sec. **28** (Blk.) **34** (Sur.) **3E** Map No.

Operator **Gross Drlg.**

Well No. **2** Farm **Baird**

Elev.	Location	SW	SW	SW
-------	----------	----	----	----

FIRST REPORT

330 Ft. From S Line SW

330 Ft. From W Line Quarter

1st. Report **FEB 17 1954**

Completion

Remarks

Spudding Date -----

Drig. Data Gibson Ext.

Cellar & pits

