


Russell KANSAS

DX 78-1

Section 34 Township 15 Range 14W

Well No. 2 Schneider "C"

Company Aladdin Pet.

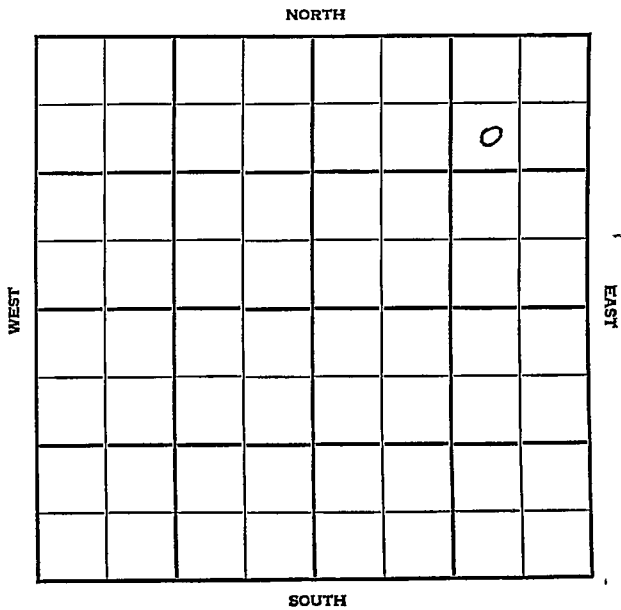

Russell KANSAS

SEC. 34	TWP. 15	R. 14W
------------	------------	-----------

WELL NO. 2 Schneider "C" FARM

COMPANY Aladdin Pet

CONTRACTOR D & G Dring.

Trapp Pool


990 Ft. from N. Line

Ft. from S. Line

990 Ft. from E. Line

Ft. from W. Line

SW NE NE

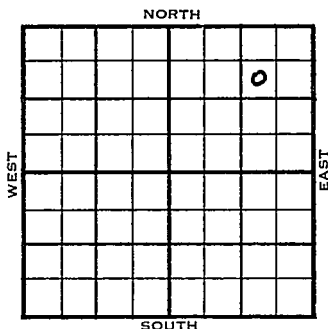

	ELEVATION	REPORT
1954	1905'	

11/7/54	Spd 7-11-54 8" @ 270 WOC
7/21	Top 2809', Heeb 3035', Tor 3051', Lans 3098', Arb. 3340' TD 3420' 5" @ 3419'
8/25	Spud 7-11-54 Oil Well TD 3420' 8" @ 270' Top 2809', Heeb 3035', Tor 3051', Lans 3098', Arb. 3340' TD 3420' 5" @ 3419' P/80 bopd CO to 3400 9/3361-64, S/5 boph 4 hrs. Comp. 40 bopd

COMPLETED

