

Section 34 Township 15 Range 14 W

Well No. # 3 Schneider "C"

Company Aladdin Pet.

NORTH

							0

WEST

EAST

SOUTH

Russell

KANSAS

SEC.	TWP.	R.
34	15	14 W

WELL NO. _____

COMPANY # 3 Schneider "C" FARM

CONTRACTOR Alladin Pet.


G & G Drlg.
Trapp Pool

330 _____ Ft. from N. Line

_____ Ft. from S. Line

330 _____ Ft. from E. Line

_____ Ft. from W. Line

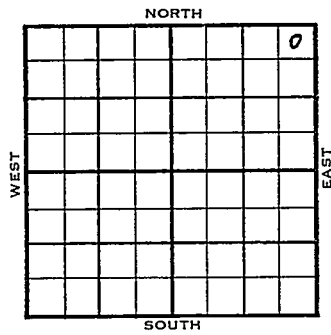

NE NE NE

	ELEVATION	REPORT
1954	1915'	
8/11	Spud 8-8-54 8" @ 277 Drlg. 1280'	
11/3	Spud 8-8-54 Oil Well TD 3430' 8" @ 277' Top 2819', Heeb 3051', Lans 3114' Arb. 3360' TD 3430' 5" @ 3429' CO to 3389' 18/ 3374-77 B/ 1/2 bo 1/4 bw. 1 hr. 250 A 1 bo 1 bwph CO to 3380 18/ 3374-77 1 boph PB 3366 43/ 3357-65 S/ 11 bfph 85% Wtr. S/ 20 bo 70 bw. 24 hr. Comp 14 bopd. 72 bw.	

COMPLETED

