


Section 23 Township 34 Range 3E

Well No. #3 Voorhis

Company Aylward Drlg.

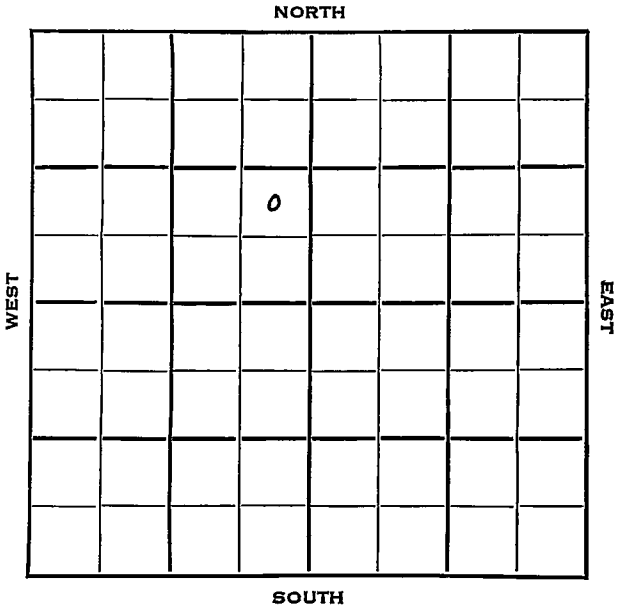

Cowley KANSAS


SEC.	TWP.	R.
23	34	3E ✓

WELL NO. _____
 COMPANY 3 Voorhis FARM

CONTRACTOR Aylward Drlg.

Harvey Pool

_____ Ft. from N. Line
 990 _____ Ft. from S. Line
 330 _____ Ft. from E. Line
 _____ Ft. from W. Line

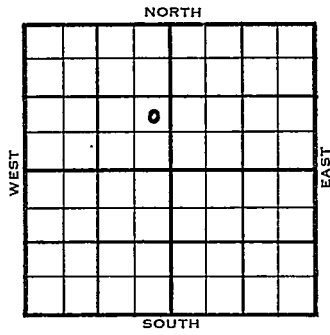

NE SE NW

1954	ELEVATION 1163'	REPORT
------	--------------------	--------

2/24
 4/14

Location
 Spud 2-25-54
 Oil Well
 TD 3377'
 8" @ 89'
 Layton 2650', KC 2880', Oswego 3051',
 Cherokee 3174', Bart 3360', Bart Sd
 3365'
 TD 3377'
 5" @ 3368'
 CO to 377'
 Hydro
 S/60 boph 12 hrs.
 Comp. 95 bopd

COMPLETED

