


Section 26 Township 34 Range 3E

Well No. #1 Bigley

Company Aylward Drlg.

NORTH

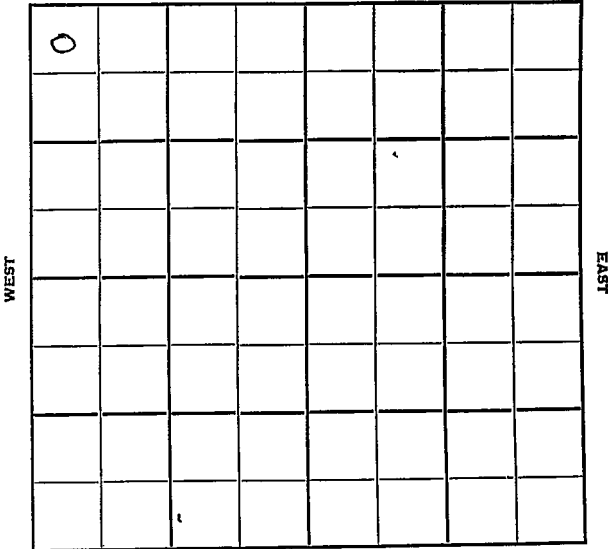

SOUTH



Sec. 26 Twp. 34 R. 3E

Well No. #1 Bigley Farm

Aylward Drlg. Company

Contractor

Ark City Pool


330' Ft. from N. Line

Ft. from S. Line

Ft. from E. Line

330' Ft. from W. Line

NW NW NW

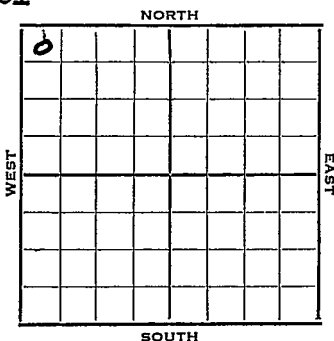

1952 Elev. 1077' REPORT

9/4 Location
Spud 9-2-52

9/17 Spud 9-2-52
D & A TD 3303' 8" @ 92
Layton 2592' KC 2778' Bart. 3281'
TD 3303' D & A

ABANDONED

County **Cowley** State **Kansas**

Sec. **26** (Blk. Twp.) **34** (Sur. Rge.) **3E** Map No.

Operator **Aylward Drig.**

Well No. **1** Farm **Bigley**

Elev. Location **NW NWNW**

0					

FIRST REPORT

330 Ft. From **N** Line **NW**

330 Ft. From **W** Line **Quarter**

1st. Report **SEP 4 1952**

Completion

Remarks

Spudding Date **9-2-52**

Drig. Data **Ark City Pool**

County Cowley State KansasSec. 26 (Bk.
Twp.) 34 (Sur.
Rge.) 3E Map No.Operator Aylward Drlg.Well No. 1 Farm BigleyElev. 1077 Location NW NWNW

0					

330 Ft. From N Line NW330 Ft. From W Line Quarter

Ist. Report

Completion SEP 17 1952Remarks Ark City PoolSpudding Date 9-2-52Drlg. Data D & A TD 33038" @ 92 Layton 2592 KC 2778Bart. 3281 TD 3303D & A

J. G. McGEHEE