


Section 26 Township 34 Range 3E

Well No. 1 Land & Power

Company Aylward Drlg.

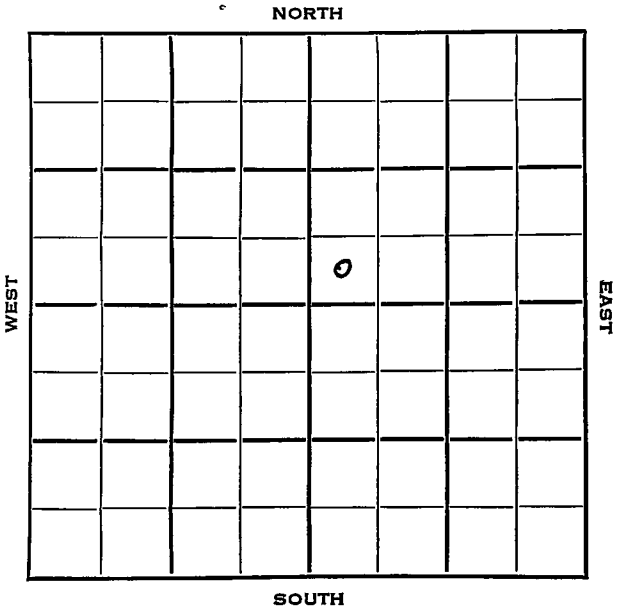

Cowley

R. KANSAS

SEC.	TWP.	R. KANSAS
26	34	3 E

WELL NO. # 1 Land & Power FARM

COMPANY

CONTRACTOR Aylward Drlg.

Aylward Harvey Pool


_____ Ft. from N. Line

330 _____ Ft. from S. Line

_____ Ft. from E. Line

330 _____ Ft. from W. Line

SW SW NE

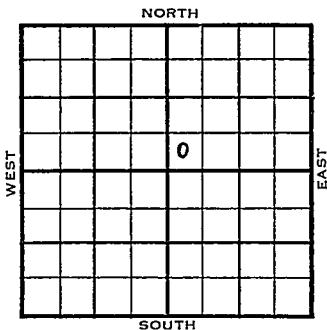

1954	ELEVATION 1076'	REPORT
------	--------------------	--------

5/5 Location

5/19 Spud 5-7-54
D & A
TD 3281'
8-5/8" @ 93'
Stal. 2284', Layton 2573' KC 2764'
Bart 3250', Bart Sd. 3275'
TD 3281'
D & A

ABANDONED

