

KANSAS

Form 51-5M-7-40-Palace


Russell

Section 35 Township 15 Range 14-W

Well No. #1 Maier "B"

Company Shell

NORTH Trapp Pool

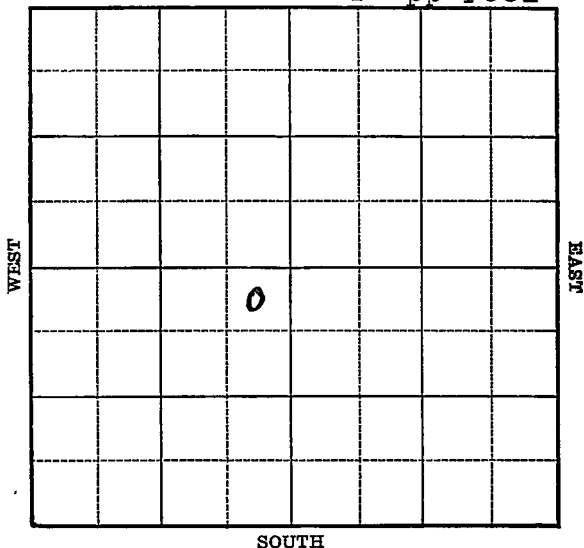

Map No. 73 Sec. 35 Twp. 15 R. 14WWell No. 1 Maier "B"Shell

Company

~~FIRST REPORT~~

Contractor

SECTION PLAT

NE SW

330


Ft. from N. Line

Ft. from S. Line

330 Ft. from E. Line

Ft. from W. Line

TRAPP POOL

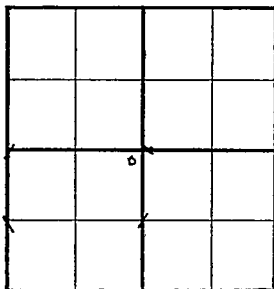

Location _____

Rig up _____

Drilling and Remarks:

Dr1g. 315'

RECORD

Cased _____ in., _____ ft.

Sand _____

Gas _____

Oil _____

Total Depth _____

PRODUCTION

1st 24 hrs.-Nat. _____

1st 24 hrs. after shot _____

Gas _____ Ga. Ft.

Dry Hole _____

Abandoned _____

Date

MAR 19 1941 19S. J. LEWIS Scout

Map No. 73 Sec. 35 Twp. 15 R. 14WWell No. 1 Maier "B"

Shell

Company

ABANDONED

Contractor

NE SW

330 Ft. from N. Line

Ft. from S. Line

330 Ft. from E. Line

Ft. from W. Line

TRAP P POOL

SECTION PLAT

	o		

Location _____

Rig up _____

Drilling and Remarks:

*Cr & 3340**4" @ 3341**Water.*

RECORD

Cased _____ in., _____ ft.

Sand _____

Gas _____

Oil _____

Total Depth 3266

PRODUCTION

1st 24 hrs. Nat. _____

1st 24 hrs. after shot _____

Gas _____ Cu. Ft.

Dry Hole _____

Abandoned _____

Date

APR 23 1941

19

S. J. LEWIS Scout