

FORM 51


Cowley

KANSAS

Section 28 Township 34 Range 3E

Well No. #1 Baird

Company Gross Drlg.

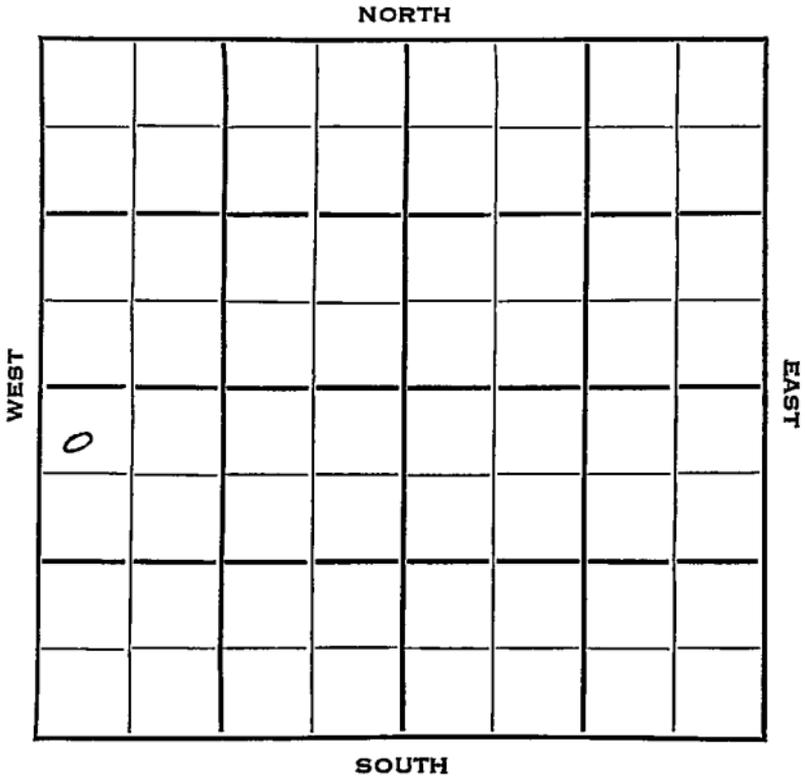

Sec. 28 Twp. 34 R. 3E

Well No. #1 Baird Farm

Gross Drlg. Company

Gross Drlg. Contractor
Gibson Pool


330 Ft. from N. Line

Ft. from S. Line

Ft. from E. Line

330 Ft. from W. Line

NW NW SW

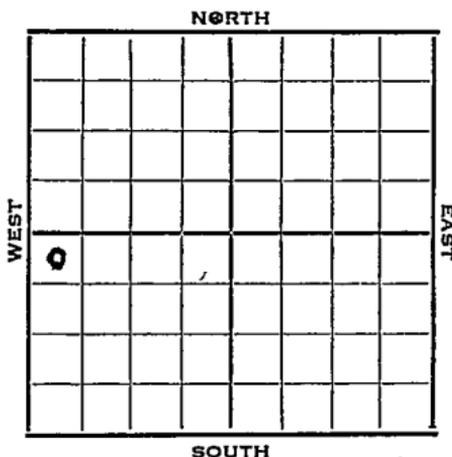

1953 Elev. 1113' REPORT

2/25 Location

4/8 Spud 2-27-53
D&A
TD 3402
DST 1434-50, opn 1/2 hrs., rec. 610' sw,
130#
Severy sd, 1432, Layton 2647, KC
2860, Oswego 3034, Bart 3336, Sat Sd.
3367
T^u 3375
5" @ 3367
CO to 3375, DD 3402, PB 1500
24/1432-40, 1/2 mcfg
D&A

ABANDONED

