

Russell


KANSAS

Form 51—5M—11-38—Palace

Section 35 Township 15 Range 14 <sup>W</sup>


Well No. 1 Mollie

Company Phillips

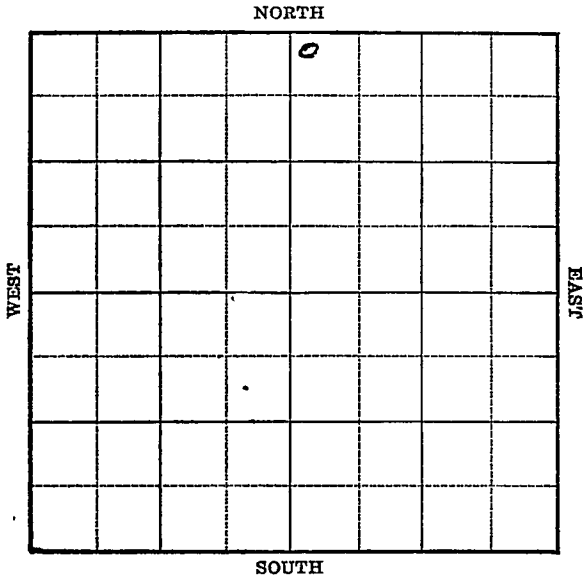

Sec. 35 Twp. 15 R. 14-WWell No. #1 Mollie FarmPhillips Company330 Ft. from N. Line         Ft. from S. Line         Ft. from E. Line330 Ft. from W. Line

Elev. 1914

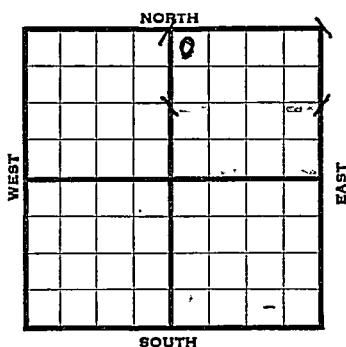

| 1938    | REPORT                                                 |
|---------|--------------------------------------------------------|
| 11/16   | Location                                               |
| 11/25   | R U R                                                  |
| 12/2    | 8" - 595'. Drlg. 1200'.                                |
| 12/3    | Dlg. -1929 (Tel) <i>Top-Topeka</i>                     |
| 12/9    | Drlg. 2560'.                                           |
| 12/13   | T.D. 3323 Lost circulation (Tel)                       |
| 12/22   | T.D. 3352 Drilled out plugs to 3352                    |
|         | No show Will core (Tel)                                |
| 12/22   | Top Arbuckle 3350 <sup>5"-3350</sup> Drilled out plugs |
|         | to 3352 No show Drilled 1 foot and                     |
|         | cored 3 feet deeper T.D. 3356                          |
|         | Filled 750' oil in 1 hour Filled up                    |
|         | 1400' oil 2 hrs. Will test (Tel)                       |
| Running | 2' lower on Arbuckle than Western                      |
| Kansas  | #1 Schneider west offset discovery well                |
| 12/23   | Filled up 3000 feet oil in 8½ hours                    |
|         | Swabbed 164 bbls. in 6 hours                           |
|         | Last 3 hrs. averaged 23 bbls. per hour                 |
|         | Swabbing off bottom May acidize (Tel)                  |
| 12/30   | SD for tanks.                                          |
|         |                                                        |
|         |                                                        |

OVER

Russell KANSAS

Map No. 72 Sec. 35 Twp. 15 R. 14WWell No. 1 MolliePhillips

Company.


Contractor

## FIRST REPORT

NW NE

330 Ft. from N. Line       Ft. from S. Line       Ft. from E. Line330 Ft. from W. Line

## SECTION PLAT

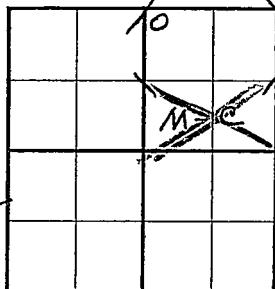Location X

## RECORD

Cased        in.,        ft.Sand       Gas       Oil       Total Depth       Rig up       

Drilling and Remarks:

## PRODUCTION

1st 24 hrs. Nat.       1st 24 hrs. after shot       Gas        Cu. Ft.Dry Hole       Abandoned       

Date

NOV 16 1938

19

H. D. Hatfield Scout

Russell

KANSAS

Map No.    Sec. 35 Twp. 15 R. 14WWell No. 1 Mollie  
Phillips

Company

Contractor

**COMPLETED**

NW NE

330 Ft. from N. Line       Ft. from S. Line       Ft. from E. Line330 Ft. from W. Line

SCHNEIDER POOL

SECTION PLAT

|  |  |   |  |
|--|--|---|--|
|  |  | 0 |  |
|  |  |   |  |
|  |  |   |  |
|  |  |   |  |
|  |  |   |  |

Location       Rig up       

Drilling and Remarks:

*2000 acid**P-435/8**pot 1304**cut 3/10 of 190 wtr*

RECORD

Cased 5 in., 3350 ft.~~Sand~~ *Arb* 3350Gas       Oil       Total Depth 3356

PRODUCTION

1st 24 hrs. Nat.       1st 24 hrs. after shot       Gas        Cu. Ft.Dry Hole       Abandoned       

Date

JAN 11 1938

19

E. D. Hatfield Scout

1939

1/6 T.D. 3356'.  
SD for tanks.

1/6--Acidized 2000 gallons  
Take potential tomorrow (Tel)

1/10--The hourly gauges were as follows:

1st hour 65 bbls.

2nd " 66 "

3rd " 57 "

4th " 51 "

5th " 52 "

6th " 51 "

7th " 49 "

8th " 44 "

Total for 8 hours 435 bbls..

24 hour potential 1304 bbls.

Cut 3/10 of 1% water. (Letter from HDH.)

1/11 5" - 3350'.

Arb. 3350'..

T. D. 3356'.

2000 acid.

Pump. 435 bbls. 8 hrs.

Potential 1304 bbls..

Cut 3/10 of .1% water.

COMPLETED