

Russell


KANSAS

SECTION 32 TOWNSHIP 15 RANGE 11 W

WELL NO. #1 Becker

COMPANY Rudy Herman

NORTH

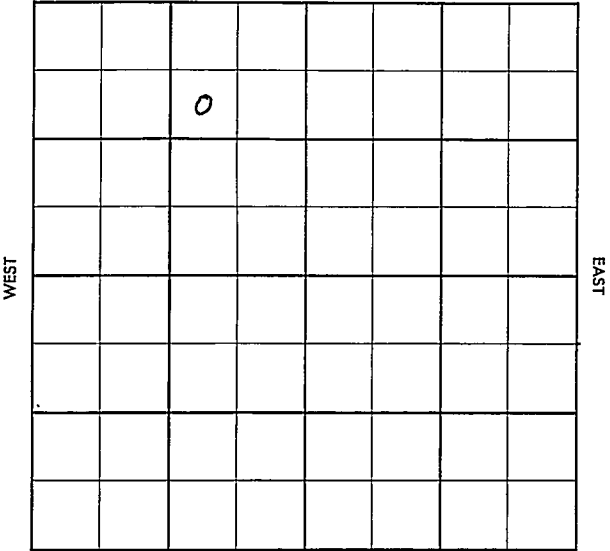

SOUTH

WEST

EAST

Russell

KANSAS


SEC.	TWP.	R.
32	15	14W

WELL NO. #1 Becker FARM

COMPANY Rudy Herman

CONTRACTOR Welch & Olsson

_____ Ft. from N. Line
 _____ Ft. from S. Line
 _____ Ft. from E. Line
 _____ Ft. from W. Line

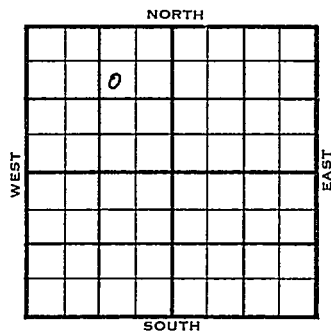

SW NE NW

	ELEVATION	REPORT
1955	1848	
10/26	Comm 10/20/55 8" @ 310/175 Drlg 2712	
11/9	Comm 10-20-55 8" @ 310/175 Anh 870 H 3004 Tr 3023 L. 3065 BKC 3271 Shly 3308 DST 3007-98 open 1 hr rec 660' msw 870/20" DST 3098-3105 open 1 hr rec 660' sw 870/20" D & A	

ABANDONED

County Russell Elev. _____
 Sec. 32 Twp. 15 Rge. 11W
 Company Rudy Herman
 FarmName Becker No. 1

TOPS	DEPTH	LOG	DATUM
Anh.			
Tp.			
H.			
Tr.			
Dg.			
Bl.			
L.			
K.C.			
B.K.C.			
Ce.			
C.			
M.			
M.			
K.			
Mz.			
Mo.			
V.			
S.			
S.			
A.			
R.			
Pe.			
G.			
T.D.			

Loc. in Sec. SW NE NW

Geol. _____

Contr. _____

Welch & Olsson

Pool _____

OCT 26 1955

FIRST REPORT

Date Comm. 10-20-55

8" @ 310/175 drlg. 2712

S

Co.

No.

No.

Sec.

T.

R.

County Russell Elev. 1848
 Sec. 32 Twp. 15 Rge. 14W
 Company Rudy Herman
 Farm Name Becker No. 1

TOPS	DEPTH	LOG	DATUM
Anh.	" 870		
Tr.			
H.	3004		1156
Dg.	3023		1175
Bl.			
L.	3065		1217
K.C.			
B.K.C.	3271		1423
Ce.			
C. <i>shaly</i>	3308		1460
M.			
M.			
K.			
Mz.			
Mo.			
V.			
S.			
S.			
A.			
R.			
Pe.			
G.			
T.D.	3330		

Loc. in Sec. SW NE NW
 Geol. _____
 Contr. Welch & Olsson
 Pool _____



Date Comm. 10-20-55 NOV 9 1955
 8" @ 310/175 DST 3007-98 open 1 hr.
 rec. 660' msW 870/20" DST 3098-3105
 open 1 hr. rec. 660' SW 870/20"
 D & A

Co.
 No.
 Sec.
 T.
 R.