


Rush

KANSAS

Section 23 Township 18 Range 16-W

Well Number 3 Koriel "B"

Company Morgan & Flynn

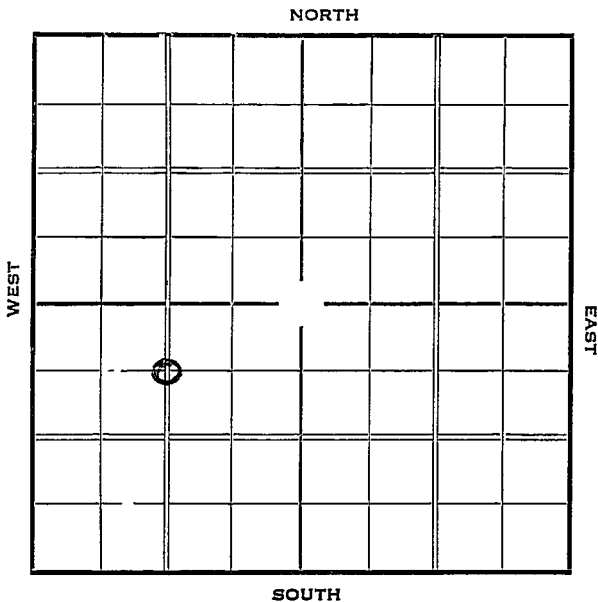

Sec. 23 Twp. 18 R. 16-W

Well No. #3 Koriel "B" Farm

Morgan & Flynn Company


660 Ft. from N. Line

_____ Ft. from S. Line

_____ Ft. from E. Line

1320 Ft. from W. Line

Elev. 1929

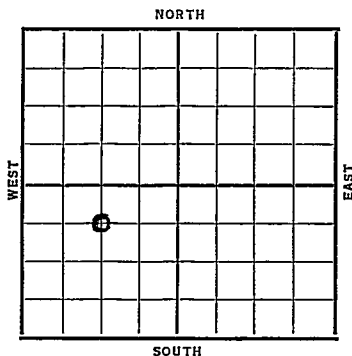

Date	REPORT
1937	
3/31	Rigging up
4/8	15" @ 212' Drlg. 640'
4/16	Anhydrate 975'. 10" @ 990'. Drlg. 1900'.
4/23	Drlg. 3434'.
4/30	Sand 3490'. 7" @ 3495'. WOC.
5/5	Sand 3490'. T.D. 3550'. Pot. 517 Oil. 45 M gas.
COMPLETED	

KANSAS *Rush*

Map No. _____ Sec. 28 Twp. 18 R. 16W.

Well No. 3 Horiz "B"

Morgan & Flynn Company
 _____ Contractor

SECTION PLAT

	c		

660 Ft. from N. Line
 _____ Ft. from S. Line
 _____ Ft. from E. Line
1820 Ft. from W. Line

FIRST REPORT

Location _____

Rig up _____

Drilling and Remarks:

Rigging up

RECORD

Cased _____ in., _____ ft.
 Sand _____
 Gas _____
 Oil _____
 Total Depth _____

PRODUCTION

1st 24 hrs. Nat. _____
 1st 24 hrs. after shot _____
 Gas _____ Cu. Ft.
 Dry Hole _____
 Abandoned _____

Date

MAY 31 1937

S. J. LEWIS

Scout

Rush KANSAS

Map No. 74 Sec. 23 Twp. 18 R. 16^W

Well No. 3 - Koriel "B"

Morgan & Flynn Company
Contractor

COMPLETED

660 Ft. from N. Line
____ Ft. from S. Line
1320 Ft. from E. Line
____ Ft. from W. Line

SECTION PLAT

	0		

Location _____

Rig up _____

Drilling and Remarks:

pot 517 oil
45 m. gas

RECORD

Cased _____ in., _____ ft.
Sand 3490
Gas _____
Oil _____
Total Depth 3550

PRODUCTION

1st 24 hrs. Nat. _____
1st 24 hrs. after shot _____
Gas _____ Cu. Ft.
Dry Hole _____
Abandoned _____

Date

MAY 5 - 1937

19

H. D. Hatfield Scout