



Map No. KANSAS Sec. 23 Twp. 18 R. 16<sup>w</sup>

Well No. 1 - Rife Farm

Slynn et al Company


1320 Ft. from N. Line

\_\_\_\_\_ Ft. from S. Line

\_\_\_\_\_ Ft. from E. Line

1320 Ft. from W. Line

1931

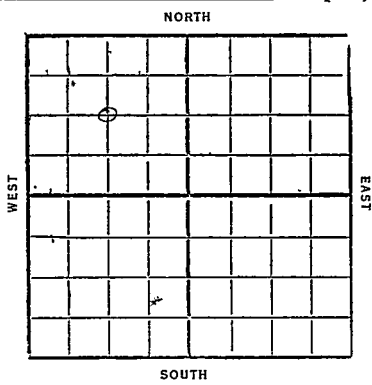

Date	REPORT	O. W. D. D
4/29	Bldg rig	
5/6	begin up	
5/13		
5/20	July 90'	
5/27		
6/3	Cam 20"-225'	
6/10	HFV 415'	
	Dreg 445'	
6/17	12"-715'	
	Dreg 725'	
6/24	513 1002' for 12"	
7/1		
7/8	12"-990' Dreg.	
7/15	Dreg 1870'	
7/22	HFV 2301-30	
	Rng 8" csg	
7/29	8"-2334'	
	Dreg 2888'	
8/5	10 boiler water from	
	3140-44	
	6"-3160	
	Dreg 3162'	

8/12- 6"-3240  
 HFW at 3245  
 Crlg 3265'

8/19- V1E 6"-3325

8/26- HFW at 3426  
 TD. 3435" Rng 6"

9/2- 6"-3477  
 show oil 3484-87  
 " gas 3493-95  
 Est 34A gas 3495-99

9/3- Total depth 3516'- Gauged  
 38 1/4 Million gas  
 (Telegram)

9/9- Cased 6"-3477  
 Sand 3493-3516  
 show oil 3484-87  
 TD. 3516

38,275,000 cu ft gas  
 Comp

1937 O.W.D.D  
 7/14 Old T.D. 3516'.  
 R. U. to deepen.  
 7/23 " " "

OVER

1937

7/28

6" @ 3477'.

Regan 3500'.

T.D. 3550'.

O.T.D. 3516'.

Flowed 1583 bbls./24 hrs &

Est. 22 M gas.

COMPLETED

*Rush*

*W*

**KANSAS**

Map No. \_\_\_\_\_ Sec. *23* Twp. *18* R. *16*

Well No. *74* *1* *Rize*

*Flynn et al* Company

Contractor

**FIRST REPORTS**

*1320* Ft. from N. Line

\_\_\_\_\_ Ft. from S. Line

\_\_\_\_\_ Ft. from E. Line

*1320* Ft. from W. Line

**SECTION PLAT**

	○		

Location \_\_\_\_\_

Rig up \_\_\_\_\_

Drilling and Remarks:

*Blow Rig.*

**RECORD**

Cased \_\_\_\_\_ in., \_\_\_\_\_ ft.

Sand \_\_\_\_\_

Gas \_\_\_\_\_

Oil \_\_\_\_\_

Total Depth \_\_\_\_\_

**PRODUCTION**

1st 24 hrs. Nat. \_\_\_\_\_

1st 24 hrs. after shot \_\_\_\_\_

Gas \_\_\_\_\_ Cu. Ft.

Dry Hole \_\_\_\_\_

Abandoned \_\_\_\_\_

Date

**APR 29 1931**

192

**CHAS. L. SHERWOOD**

Scout

*Rush*

74 KANSAS Map No. Sec. 23 Twp. 18 R. 16 W

Well No. 1 *Rise*


*Flynn & Co* Company

Contractor

COMPLETED

SECTION PLAT

1320 Ft. from N. Line  
 \_\_\_\_\_ Ft. from S. Line  
 \_\_\_\_\_ Ft. from E. Line  
 1320 Ft. from W. Line

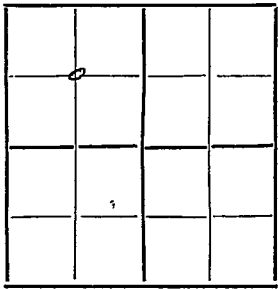

Location \_\_\_\_\_

Rig up \_\_\_\_\_

Drilling and Remarks:

*Show Oil 3/8/87*

RECORD

Cased 6 in., 3477 ft.

Sand 3499-3516

Gas \_\_\_\_\_

Oil \_\_\_\_\_

Total Depth 3516

PRODUCTION

1st 24 hrs. Nat. \_\_\_\_\_

1st 24 hrs. after shot \_\_\_\_\_

Gas 38, 275,000 Cu. Ft.

Dry Hole \_\_\_\_\_

Abandoned \_\_\_\_\_

Date

SEP 9 1931 CHAS. L. SHERWOOD

192 Scout

*Rush* KANSAS

Map No. \_\_\_\_\_ Sec. 23 Twp. 18 R. 16<sup>w</sup>

Well No. 1 - Rife

*Morgan & Flynn* Company  
Contractor

**FIRST REPORT**

**SECTION PLAT**

1320 Ft. from N. Line  
 \_\_\_\_\_ Ft. from S. Line  
 \_\_\_\_\_ Ft. from E. Line  
1320 Ft. from W. Line

	○		

Location \_\_\_\_\_

Rig up \_\_\_\_\_

Drilling and Remarks:

*OWDD*  
*OTD 3516*  
*R. U. To deeper*

**RECORD**

Cased \_\_\_\_\_ in., \_\_\_\_\_ ft.  
 Sand \_\_\_\_\_  
 Gas \_\_\_\_\_  
 Oil \_\_\_\_\_  
 Total Depth \_\_\_\_\_

**PRODUCTION**

1st 24 hrs. Nat. \_\_\_\_\_  
 1st 24 hrs. after shot \_\_\_\_\_  
 Gas \_\_\_\_\_ Cu. Ft.  
 Dry Hole \_\_\_\_\_  
 Abandoned \_\_\_\_\_

Date

JUL 14 1937 19

H. D. Hatfield Scout

Rush KANSAS

Map No. 74 Sec. 23 Twp. 18 R. 16 W

Well No. 1 - Rife

Morgan & Flynn Company

Contractor

COMPLETED

SECTION PLAT

1320 Ft. from N. Line

\_\_\_\_\_ Ft. from S. Line

\_\_\_\_\_ Ft. from E. Line

1320 Ft. from W. Line


— OWDD —

Location \_\_\_\_\_

Rig up \_\_\_\_\_

Drilling and Remarks:

OTD 3516

flowed 1583 bbls oil  
24 hrs

EST 22 M 985

RECORD

Cased 6 in., 3477 ft.

Sand Regan 3500

Gas \_\_\_\_\_

Oil \_\_\_\_\_

Total Depth 3550

PRODUCTION

1st 24 hrs. Nat. \_\_\_\_\_

1st 24 hrs. after shot \_\_\_\_\_

Gas \_\_\_\_\_ Cu. Ft.

Dry Hole \_\_\_\_\_

Abandoned \_\_\_\_\_

Date

JUL 28 1937

H. D. Hatfield

Scout