

Map No. _____ Sec. 17 Twp. 28 R. 4

Well No. 6 Long _____ Farm _____
Euphonia _____ Company _____

NORTH



SOUTH

Location _____

Rig Up _____

Drilling Remarks:

Drilling Remarks:

RECORD

PRODUCTION

Cased _____ in. _____ ft.

1st 24 hrs. Nat. _____

Sand _____

1st 24 hrs. after shot _____

Gas _____

Gas _____ cu. ft

Oil _____

Dry Hole _____

Total Depth _____

Abandoned _____

Map No. _____ Sec. 17 Twp. 28 R. 4Well No. 6 Long _____ Farm

_____ Company

NORTH

WEST

EAST

SOUTH

Location _____

Rig Up ☒ _____

Drilling and remarks

915' S 7 N I
330 W 7 CP

FIRST REPORT

RECORD

Cased _____ in. _____ Ft.

Sand _____

Gas _____

Oil _____

Total Depth _____

PRODUCTION

1st 24 hrs. Nat. _____

1st 24 hrs. after shot _____

Gas _____ Cu. Ft.

Dry Hole _____

Abandoned _____

Date

_____, 1917Carroll

Scout

Map No. _____ Sec. 17 Twp. 28 R. 4


Well No. 6 Farm _____

Engine Company _____

NORTH

WEST

EAST

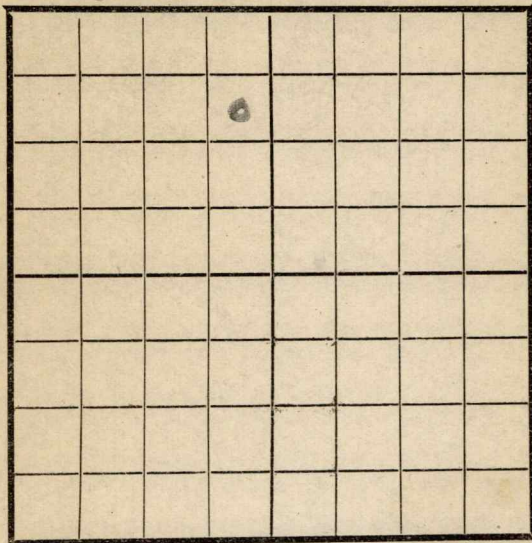

SOUTH

Location _____

Rig Up _____

Drilling and remarks _____

RECORD

Cased _____ in. _____ Ft.

Sand _____

Gas _____

Oil _____

Total Depth _____

PRODUCTION

1st 24 hrs. Nat. _____

1st 24 hrs. after shot _____

Gas _____ Cu. Ft.

Dry Hole _____

Abandoned _____

Date

11-7, 1917 Conley Scout

Map No. _____ Sec. 17 Twp. 28 R. 4Well No. 6 Long Farm _____Company Engineer

NORTH

WEST

EAST

SOUTH

Location _____

Rig Up ☒

Drilling and remarks _____

RECORD

Cased _____ in. _____ Ft.

Sand _____

Gas _____

Oil _____

Total Depth _____

PRODUCTION

1st 24 hrs. Nat. _____

1st 24 hrs. after shot _____

Gas _____ Cu. Ft.

Dry Hole _____


Abandoned _____

Date

11/14, 1917 Long Scout

Map No. _____ Sec. 17 Twp. 28 R. 4
Well No. 6401 Farm _____
Empire Company

NORTH

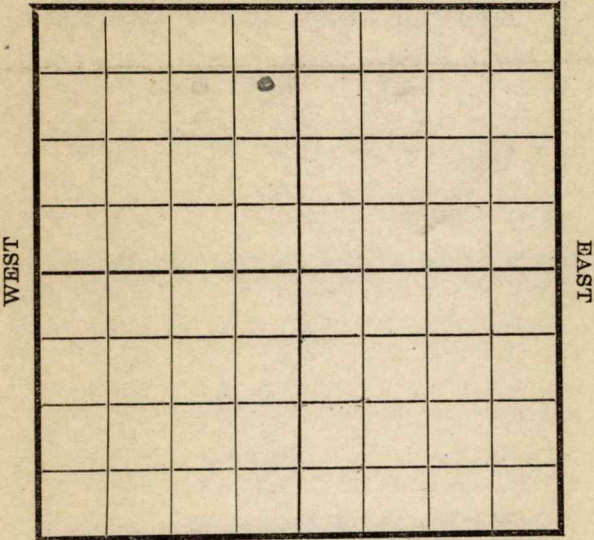

SOUTH

Location _____
Rig Up _____
Drilling and remarks _____

RECORD

Cased _____ in. _____ Ft.
Sand _____
Gas _____
Oil _____
Total Depth _____

PRODUCTION

1st 24 hrs. Nat. _____
1st 24 hrs. after shot _____
Gas _____ Cu. Ft.
Dry Hole _____
Abandoned _____


Date

11/31, 1917 Empire Scout

Map No. _____ Sec. 17 Twp 28 R. 4Well No. 6 Long _____ Farm _____Engine _____ Company _____

NORTH

WEST

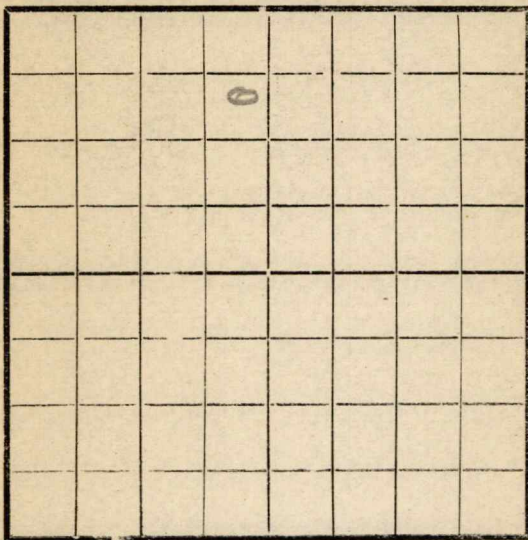

EAST

SOUTH

Location _____

Rig Up ☒ _____

Drilling and remarks _____

RECORD

Cased _____ in. _____ Ft.

Sand _____

Gas _____

Oil _____

Total Depth _____

PRODUCTION

1st 24 hrs. Nat. _____

1st 24 hrs. after shot _____

Gas _____ Cu. Ft.

Dry Hole _____

Abandoned _____


Date

11/28, 1917 Carby _____ Scout _____

Map No. _____ Sec. 17 Twp. 28 R. 4Well No. 6201 Farm __________
Company _____

NORTH

WEST

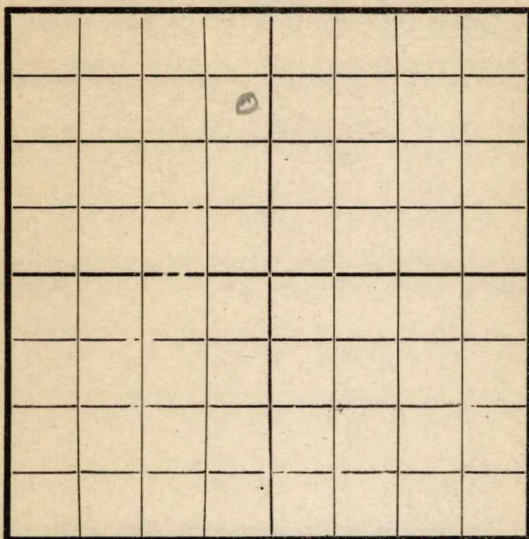

EAST

SOUTH

Location _____

Rig Up _____

Drilling and remarks _____

RECORD

Cased _____ in. _____ Ft.

Sand _____

Gas _____

Oil _____

Total Depth _____

PRODUCTION

1st 24 hrs. Nat. _____

1st 24 hrs. after shot _____

Gas _____ Cu. Ft.

Dry Hole _____

Abandoned _____

Date

12/5, 1917 Scout

Map No. _____ Sec. 17 Twp. 28 R. 4Well No. 6 Long Farm _____Empire Company _____

NORTH

WEST

EAST

SOUTH

Location _____

Rig Up _____

Drilling and remarks _____

RECORD

Cased _____ in. _____ Ft.

Sand _____

Gas _____

Oil _____

Total Depth _____

PRODUCTION

1st 24 hrs. Nat. _____

1st 24 hrs. after shot _____

Gas _____ Cu. Ft.

Dry Hole _____

Abandoned _____


Date

10/12, 1917 Candy Scout

Map No. _____ Sec. 17 Twp. 28 R. 4
Well No. 6 Long Farm _____
Angus Company _____

NORTH

WEST

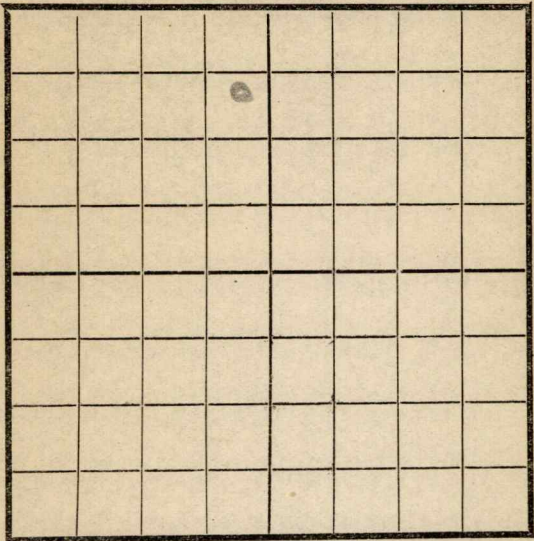

EAST

SOUTH

Location _____
Rig Up ☒ _____
Drilling and remarks

LD

RECORD

Cased _____ in. _____ Ft.
Sand _____
Gas _____
Oil _____
Total Depth _____

PRODUCTION

1st 24 hrs. Nat. _____
1st 24 hrs. after shot _____
Gas _____ Cu. Ft.
Dry Hole _____
Abandoned _____

Date 12/19, 1912 Scout Angus

Map No. _____ Sec. 17 Twp. 28 R. 4Well No. 6 Long Farm _____
Empire Gas Company _____

NORTH

WEST

EAST

SOUTH

Location _____

Rig Up ✓ _____

Drilling and remarks _____

RECORD

Cased _____ in. _____ Ft.

Sand _____

Gas _____

Oil _____

Total Depth _____

PRODUCTION

1st 24 hrs. Nat. _____

1st 24 hrs. after shot _____

Gas _____ Cu. Ft.

Dry Hole _____

Abandoned _____


Date

1/2, 1918 Candell Scout

Map No. _____ Sec. 17 Twp. 28 R. 4
 Well No. 6 Long Farm _____
Empire Company _____

NORTH

WEST

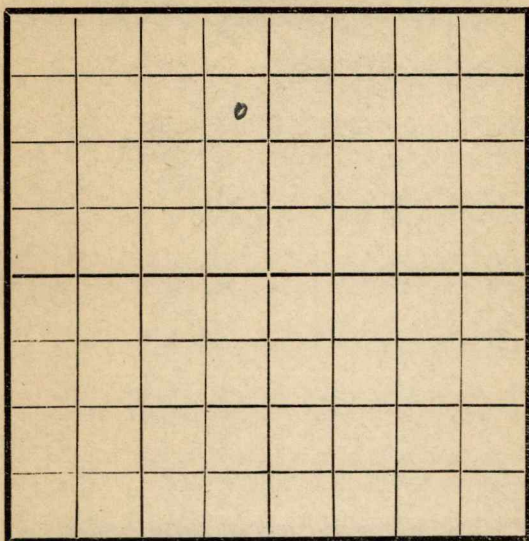

EAST

SOUTH

Location _____
 Rig Up ☒ _____
 Drilling and remarks _____

RECORD

Cased _____ in. _____ Ft.
 Sand _____
 Gas _____
 Oil _____
 Total Depth _____

PRODUCTION

1st 24 hrs. Nat. _____
 1st 24 hrs. after shot _____
 Gas _____ Cu. Ft.
 Dry Hole _____
 Abandoned _____

Date


1/16, 1918 Conroy Scout

Map No. _____ Sec. 17 Twp. 28 R. 4

Well No. 6 Long _____ Farm
Auguste _____ Company

NORTH

WEST

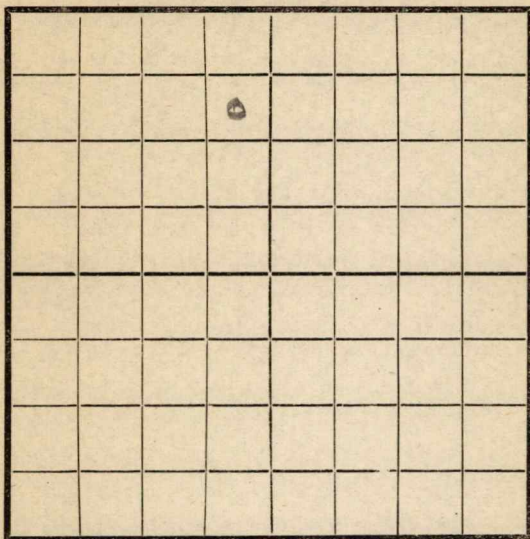

EAST

SOUTH

Location _____

Rig Up _____

Drilling and remarks

RECORD

Cased _____ in. _____ Ft.

Sand _____

Gas _____

Oil _____

Total Depth _____

PRODUCTION

1st 24 hrs. Nat. _____

1st 24 hrs. after shot _____

Gas _____ Cu. Ft.

Dry Hole _____

Abandoned _____

Date

2/13, 1918 Auguste _____ Scout

940


(M B Kelley
 Contractor
 Auguste)

Map No. _____ Sec. 17 Twp. 28 R. 4

Well No. 6 Lang Farm _____
Engine Company _____

NORTH

WEST

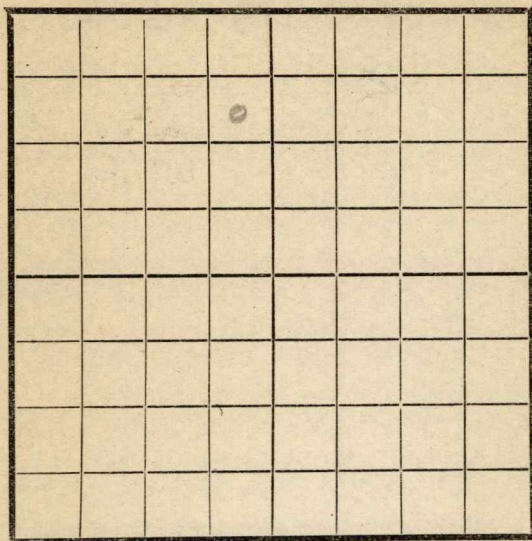

EAST

SOUTH

Location _____

Rig Up _____

Drilling and remarks

1075

RECORD

Cased _____ in _____ Ft.

Sand _____

Gas _____

Oil _____

Total Depth _____

PRODUCTION

1st 24 hrs. Nat. _____

1st 24 hrs. after shot _____

Gas _____ Cu. Ft.

Dry Hole _____

Abandoned _____

Date


3/20, 1918 S. C. Conley Scout

Map No. _____ Sec. 17 Twp. 28 R. 4

Well No. 6 Long _____ Farm
Empire _____ Company

NORTH

WEST

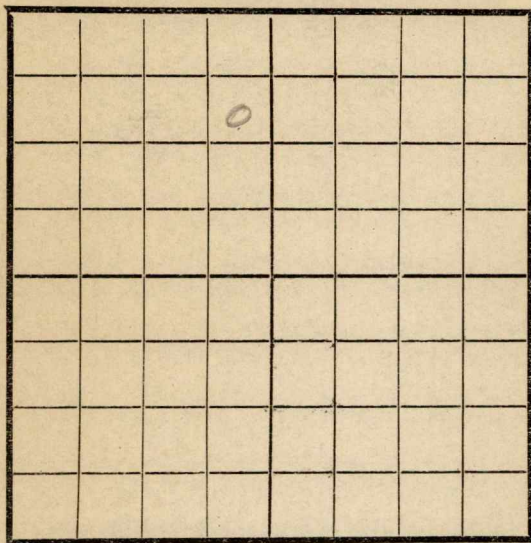

EAST

SOUTH

Location _____

Rig Up _____

Drilling and remarks

RECORD

Cased _____ in. _____ Ft.

Sand _____

Gas _____

Oil _____

Total Depth _____

PRODUCTION

1st 24 hrs. Nat. _____

1st 24 hrs. after shot _____

Gas _____ Cu. Ft.

Dry Hole _____

Abandoned _____

Date

3/27, 1918 Scout

WEST

EAST

SOUTH

RECORD

Cased _____ in. _____ Ft.
 Sand _____
 Gas _____
 Oil _____
 Total Depth _____


PRODUCTION

1st 24 hrs. Nat.-----
1st 24 hrs. after shot-----
Gas ----- Cu. Ft.
Dry Hole -----
Abandoned -----

Date _____

3/6, 1911. S. C. ... Scout

Map No. _____ Sec. 17 Twp. 28 R. 4
Well No. 6 Loring Farm _____
Cumprich Company _____
NORTH

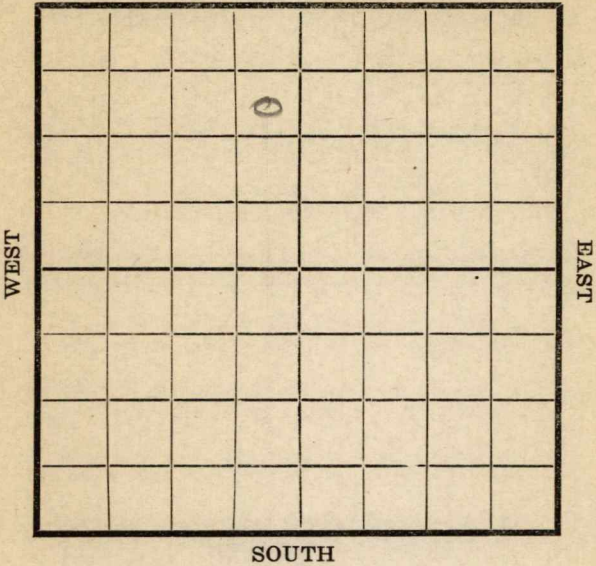


	RECORD
Location _____	Cased _____ in. _____ Ft.
Rig Up _____	Sand _____
Drilling and remarks	Gas _____
	Oil _____
	Total Depth _____
	PRODUCTION
	1st 24 hrs. Nat. _____
	1st 24 hrs. after shot _____
	Gas _____ Cu. Ft.
	Dry Hole _____
	Abandoned _____

Date 3/13 1918 Cumprich Scout

Map No. _____ Sec. 17 Twp. 28 R. 4Well No. 6 Long Farm _____Engineer Company _____

NORTH

WEST

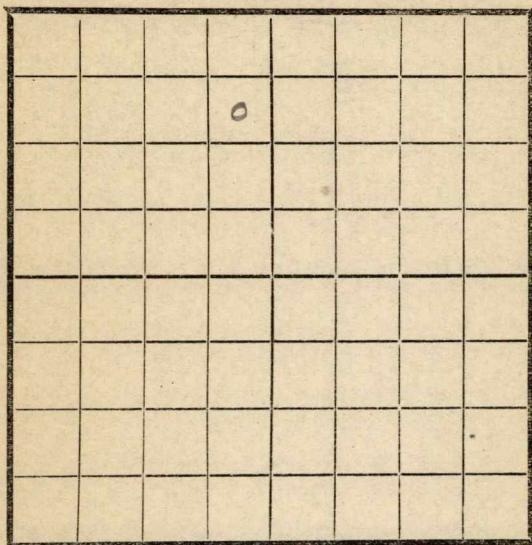

SOUTH

Location _____

Rig Up _____

Drilling and remarks

DD 2365

RECORD

Cased _____ in. _____ Ft.

Sand _____

Gas _____

Oil _____

Total Depth _____

PRODUCTION

1st 24 hrs. Nat. _____

1st 24 hrs. after shot _____

Gas _____ Cu. Ft.

Dry Hole _____

Abandoned _____

Date


3/20, 1918 J. C. Cady Scout

Map No. _____ Sec. 17 Twp. 28 R. 4Well No. 6 Long _____ Farm _____

_____ Company _____

NORTH

WEST

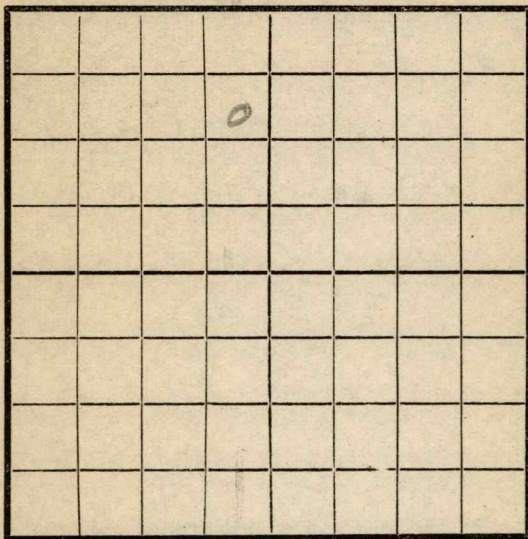

EAST

SOUTH

Location _____

Rig Up _____

Drilling and remarks

2382

RECORD

Cased _____ in. _____ Ft.

Sand _____

Gas _____

Oil _____

Total Depth _____

PRODUCTION

1st 24 hrs. Nat. _____

1st 24 hrs. after shot _____

Gas _____ Cu. Ft.

Dry Hole _____


Abandoned _____

Date

3/27, 1911 S. C. C. C. Scout

Map No. K11 Sec. 17 Twp. 28 R. 4
 Well No. 6 Long Farm _____
Empire Company _____

NORTH

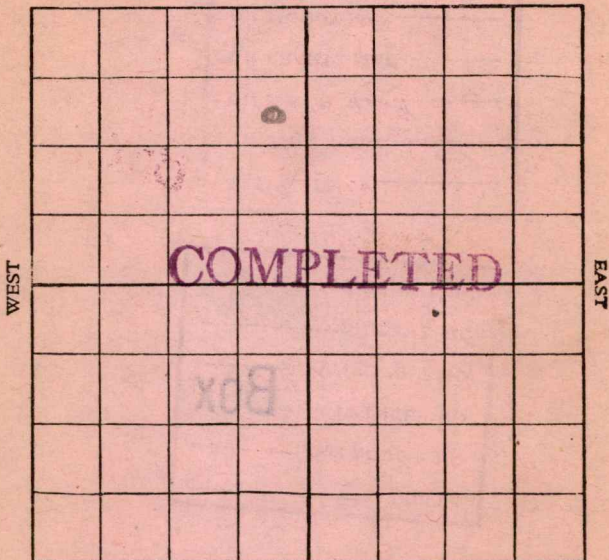

SOUTH

Location _____

Rig up _____

Drilling and remarks:

Est at
75 Bbls

RECORD

Cased _____ in. _____ Ft.

Sand 2382 - 2397

Gas _____

Oil _____

Total Depth _____

PRODUCTION

1st 24 hrs. Nat. _____

1st 24 hrs. after shot _____

Gas _____ Cu. Ft.

Dry Hole _____

Abandoned _____

Date

4/13, 1918, Scout