

Map No. 8 Sec. 17 Twp. 28 R. 4

Well No. 9 m Pine Farm _____

Company _____

NORTH

WEST

EAST



SOUTH

Location _____

Rig Up _____

Drilling Remarks:

Drilling Remarks:

RECORD

Cased _____ in. _____ ft.

Sand _____

Gas _____

Oil _____

Total Depth _____

PRODUCTION

1st 24 hrs. Nat. _____

1st 24 hrs. after shot _____

Gas _____ cu. ft.

Dry Hole _____

Abandoned _____

Map No. 1002 K11 Sec. 17 Twp. 28 R. 4


Well No. 8 Long Farm

Engle Company

NORTH

WEST

EAST

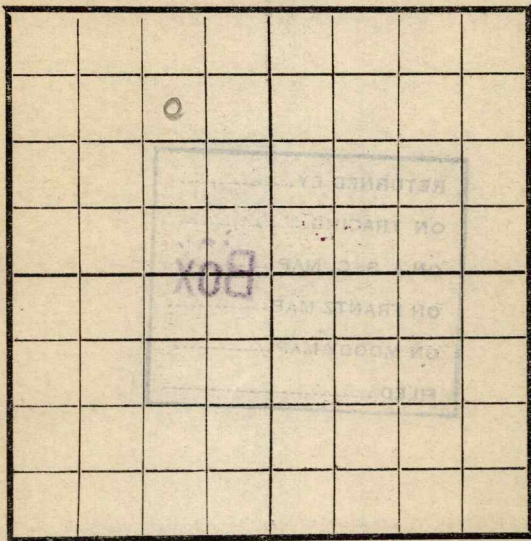

SOUTH

RECORD

Location -----

Cased ----- in ----- Ft

Rig Up ☒ -----

Sand -----

Drilling and remarks

Gas -----

Oil -----

Total Depth -----

PRODUCTION

1st 24 hrs. Nat. -----

1st 24 hrs. after shot -----

Gas ----- Cu. Ft.

Dry Hole -----

Abandoned -----

FIRST REPORT

Date

5/8, 1918 8 Long Scout

Map No. _____ Sec. 17 Twp. 28 R. 4Well No. 8 Long

_____ Company

_____ Contractor

NORTH

WEST

EAST

SOUTH

Location _____

Rig up ☒

Drilling and Remarks:

RECORD

Cased _____ in., _____ ft.

Sand _____

Gas _____

Oil _____

Total Depth _____

PRODUCTION

1st 24 hrs. Nat. _____

1st 24 hrs. after shot _____

Gas _____ Cu. Ft.

Dry Hole _____

Abandoned _____

Date

6/26 191 P. Condy Scout

Map No. _____ Sec. 17 Twp. 28 R. 4Well No. 8 Long _____

Company _____

Contractor Kingsbury & SobrechtNORTH 75

WEST

EAST

SOUTH

Location _____

Rig up _____

Drilling and Remarks:

Spudding

RECORD

Cased _____ in., _____ ft.

Sand _____

Gas _____

Oil _____

Total Depth _____

PRODUCTION

1st 24 hrs. Nat. _____

1st 24 hrs. after shot _____

Gas _____ Cu. Ft.

Dry Hole _____

Abandoned _____

Date

7/3 191 8 Long Scout

Map No. _____ Sec. 17 Twp. 28 R. 4Well No. 8 Long

Company _____

Contractor _____

NORTH

WEST

EAST

SOUTH

Location _____

Rig up _____

Drilling and Remarks:

220

RECORD

Cased _____ in., _____ ft.

Sand _____

Gas _____

Oil _____

Total Depth _____

PRODUCTION

1st 24 hrs. Nat. _____

1st 24 hrs. after shot _____

Gas _____ Cu. Ft.

Dry Hole _____

Abandoned _____

Date

7/10 191 J. C. Card

Scout

Map No. _____ Sec. 17 Twp. 28 R. 4Well No. 8 Larry

_____ Company

_____ Contractor

NORTH

WEST

EAST

SOUTH

Location _____

Rig up _____

Drilling and Remarks:

380

RECORD

Cased _____ in., _____ ft.

Sand _____

Gas _____

Oil _____

Total Depth _____

PRODUCTION

1st 24 hrs. Nat. _____

1st 24 hrs. after shot _____

Gas _____ Cu. Ft.

Dry Hole _____

Abandoned _____

Date

7/12 191 J. C. Conduff Scout

Map No. _____ Sec. 17 Twp. 28 R. 4Well No. 8 Long

Company _____

Contractor _____

NORTH

WEST

EAST

SOUTH

Location _____

Rig up _____

Drilling and Remarks:

700

RECORD

Cased _____ in., _____ ft.

Sand _____

Gas _____

Oil _____

Total Depth _____

PRODUCTION

1st 24 hrs. Nat. _____

1st 24 hrs. after shot _____

Gas _____ Cu. Ft.

Dry Hole _____

Abandoned _____

Date


7/24 191 P. Long Scout

7/31 1918 C. Carney Scout

Map No. _____ Sec. 17 Twp. 28 R. 4Well No. 8 LongEmpire _____ Company

_____ Contractor

NORTH

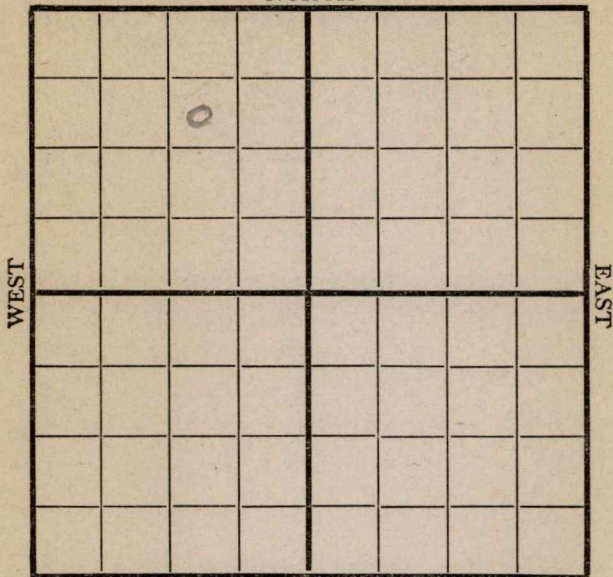

SOUTH

990788

Location _____

Rig up _____

Drilling and Remarks:

16.45

RECORD

Cased _____ in., _____ ft.

Sand _____

Gas _____

Oil _____

Total Depth _____

PRODUCTION

1st 24 hrs. Nat. _____

1st 24 hrs. after shot _____

Gas _____ Cu. Ft.

Dry Hole _____

Abandoned _____

Date

8/7

191

J. C. Condit

Scout

Map No. _____ Sec. 17 Twp. 28 R. 4Well No. 8 Long


_____ Company

_____ Contractor

NORTH

WEST

EAST

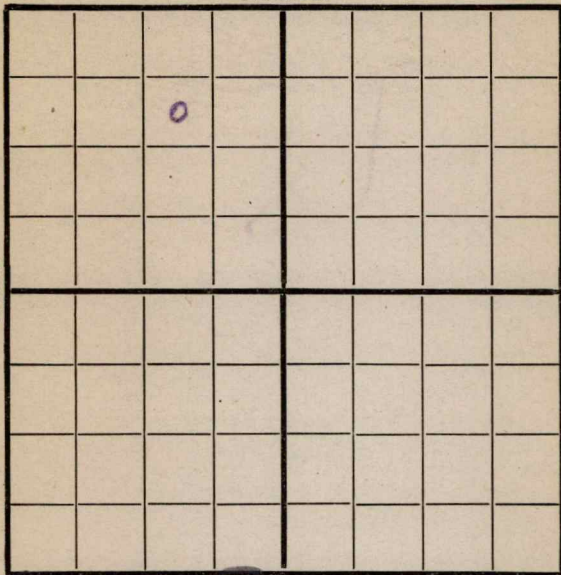

SOUTH

Location _____

Rig up _____

Drilling and Remarks:

1700

RECORD

Cased _____ in., _____ ft.

Sand _____

Gas _____

Oil _____

Total Depth _____

PRODUCTION

1st 24 hrs. Nat. _____

1st 24 hrs. after shot _____

Gas _____ Cu. Ft.

Dry Hole _____

Abandoned _____

Date

8/14/1918

191

Scout


Map No. _____ Sec. 17 Twp. 28 R. 4Well No. 8 LongEmpire Company

Contractor _____

NORTH

WEST

EAST

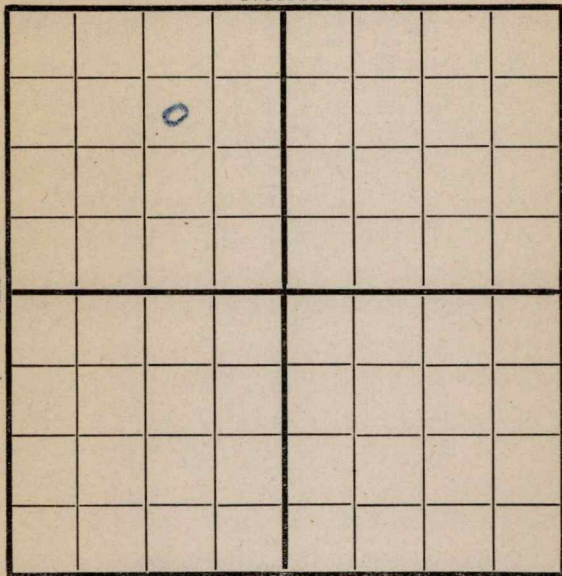

SOUTH

Location _____

Rig up _____

Drilling and Remarks:

SD 1734
Collapsed
Casing

RECORD

Cased _____ in., _____ ft.

Sand _____

Gas _____

Oil _____

Total Depth _____

PRODUCTION

1st 24 hrs. Nat. _____

1st 24 hrs. after shot _____

Gas _____ Cu. Ft.

Dry Hole _____

Abandoned _____

Date

8/21 1918 Candy Scout

Map No. 1511 Sec. 17 Twp. 28 R. 4Well No. 8 Long


Company _____

Contractor _____

NORTH

WEST

EAST

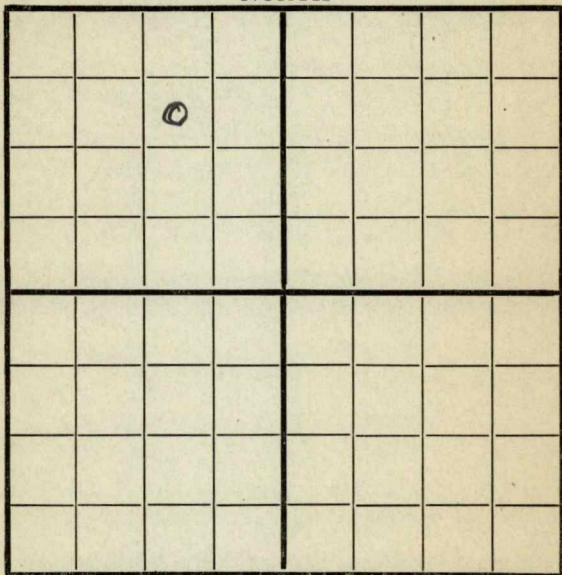

SOUTH

990 N 4 E

Location _____

Rig up _____

Drilling and Remarks:

*Collapsed
Casing
1734*

RECORD

Cased _____ in., _____ ft.

Sand _____

Gas _____

Oil _____

Total Depth _____

PRODUCTION

1st 24 hrs. Nat. _____

1st 24 hrs. after shot _____

Gas _____ Cu. Ft.

Dry Hole _____

Abandoned _____


Date

8/28 f Canby

191

Scout

Map No. 1511 Sec. 17 Twp. 28 R. 4
Well No. 8 Long
E. Long Company
Contractor

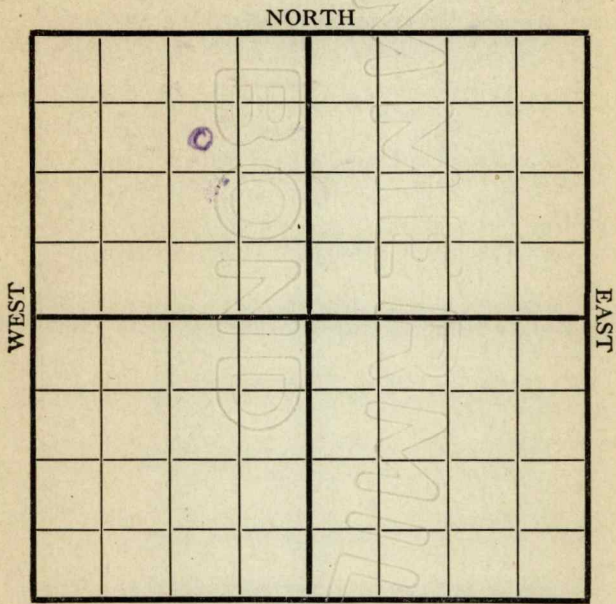

Location _____
Rig up _____
Drilling and Remarks:

1860

RECORD

Cased _____ in., _____ ft.
Sand _____
Gas _____
Oil _____
Total Depth _____

PRODUCTION

1st 24 hrs. Nat. _____
1st 24 hrs. after shot _____
Gas _____ Cu. Ft.
Dry Hole _____
Abandoned _____

Date 9/4 1918 S. C. Caudill Scout


Map No. 1511 Sec. 17 Twp. 28 R. 4Well No. 8 LongEmpire Company

Contractor

NORTH

WEST

EAST

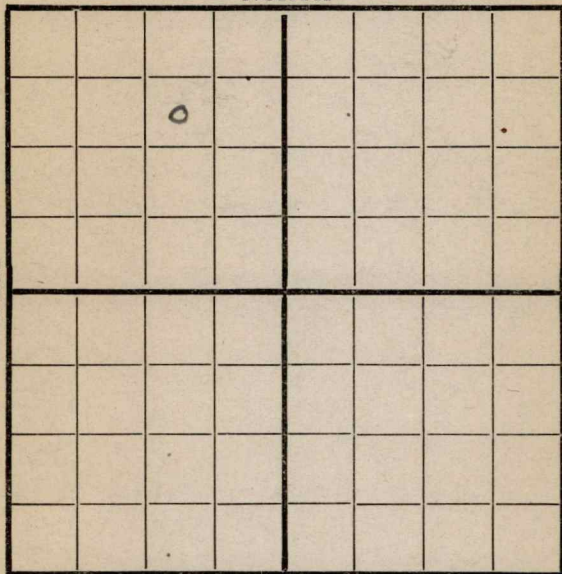

SOUTH

990 N 9 E

Location _____

Rig up _____

Drilling and Remarks:

Fishing
2035

RECORD

Cased _____ in., _____ ft.

Sand _____

Gas _____

Oil _____

Total Depth _____

PRODUCTION

1st 24 hrs. Nat. _____

1st 24 hrs. after shot _____

Gas _____ Cu. Ft.

Dry Hole _____

Abandoned _____

Date

9/11 1918 Candry Scout

Map No. 1511 Sec. 17 Twp. 28 R. 4

Well No. 8 Landing

Empire Company

Contractor

NORTH

WEST

EAST

SOUTH

990 x 9 E

Location _____

Rig up _____

Drilling and Remarks:

2190

RECORD

Cased _____ in., _____ ft.

Sand _____

Gas _____

Oil _____

Total Depth _____

PRODUCTION

1st 24 hrs. Nat. _____

1st 24 hrs. after shot _____

Gas _____ Cu. Ft.

Dry Hole _____

Abandoned _____

Date

9/18

191

8 Landing

Scout

Map No. K11 Sec. 17 Twp. 38 R. 4Well No. 8 Long

Company _____

Contractor _____

NORTH

WEST

EAST

SOUTH

Location _____

Rig up _____

Drilling and Remarks:

2300

RECORD

Cased _____ in., _____ ft.

Sand _____

Gas _____

Oil _____

Total Depth _____

PRODUCTION

1st 24 hrs. Nat. _____

1st 24 hrs. after shot _____

Gas _____ Cu. Ft.

Dry Hole _____

Abandoned _____

Date

9/25 1918 Long Scout

Map No. K11 Sec. 17 Twp. 38 R. 4Well No. 8 LongCompany Evergreen

Contractor

NORTH

WEST

COMPLETED

EAST

SOUTH

Location 990 N.E.

Rig up

Drilling and Remarks:

RECORD

Cased _____ in., _____ ft.

Sand 2379-2415

Gas _____

Oil _____

Total Depth _____

PRODUCTION

1st 24 hrs. Nat. _____

1st 24 hrs. after shot _____

Gas _____ Cu. Ft.

Dry Hole _____

Abandoned _____

Date

10/2 191 J. C. Cuddy Scout