


Map No. _____ Sec 17 Twp 28 R 4
 Well No. 14 Smith Farm _____
Empire Company

NORTH

WEST

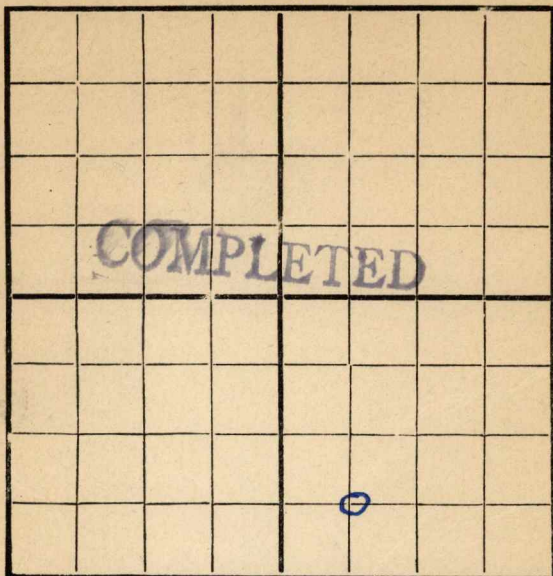

EAST

SOUTH

Location _____

Rig Up 4/10/1917

Drilling Remarks:

Drilling Remarks:

RECORD


Cased _____ in _____ Ft.
 Sand _____
 Gas _____
 Oil _____
 Total Depth _____

PRODUCTION

1st 24 hrs. Nat. _____
 1st 24 hrs. after shot _____
 Gas _____ Cu. Ft.
 Dry Hole _____
 Abandoned _____

Map No. _____ Sec. 17 Twp. 28 R. 4
Well No. 14 Smith Farm _____
Empire Company _____

NORTH

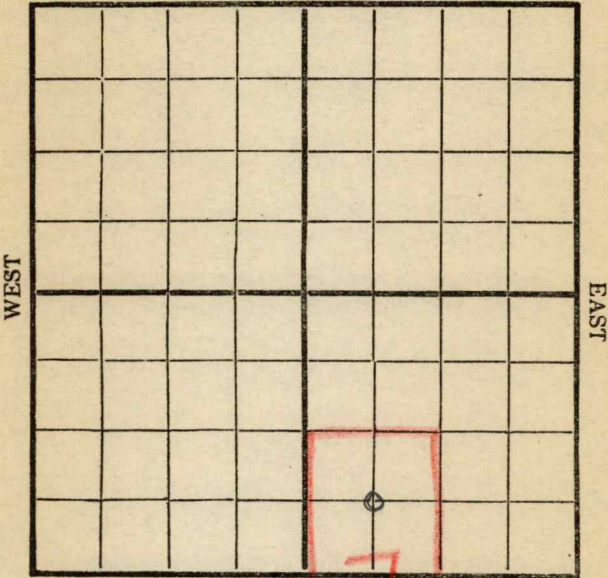

SOUTH

Location _____
Rig Up ☒ _____
Drilling and remarks _____

RECORD

Cased _____ in. _____ Ft.
Sand _____
Gas _____
Oil _____
Total Depth _____


FIRST REPORT

PRODUCTION

1st 24 hrs. Nat. _____
1st 24 hrs. after shot _____
Gas _____ Cu. Ft.
Dry Hole _____
Abandoned _____

Date 4/10, 1917 C. C. Clegg Scout

Map No. _____ Sec. 17 Twp. 28 R. 4
Well No. 14 Smith Farm _____
Cumprine Company _____
NORTH

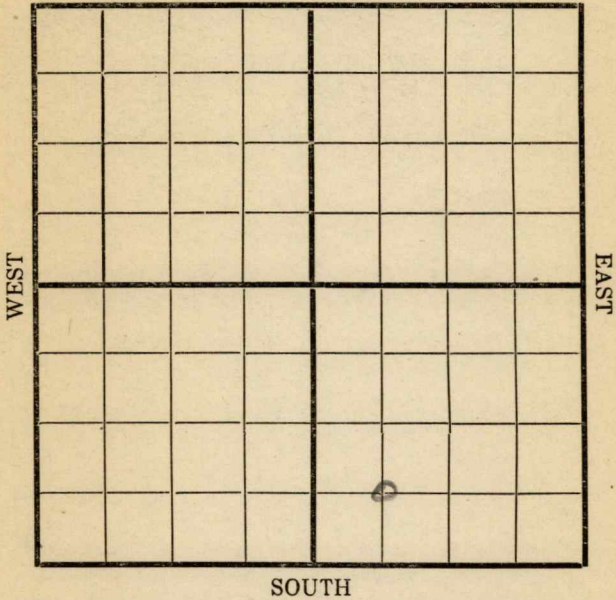

Location _____ Rig Up _____ Drilling and remarks _____	RECORD
	Cased _____ in. _____ Ft.
	Sand _____
	Gas _____
	Oil _____
	Total Depth _____
	PRODUCTION
	1st 24 hrs. Nat. _____
	1st 24 hrs. after shot _____
	Gas _____ Cu. Ft.
	Dry Hole _____
	Abandoned _____

Date 4/17 1917 Cumprine Scout

Map No. _____ Sec. _____ Twp. _____ R. _____

Well No. 14 Simula Farm

_____ Company

NORTH

[illegible]

SOUTH

Location _____

Rig Up-----

Drilling and remarks

RECORD

Cased-----in. -----Ft.

Sand_____

Gas _____

Oil _____

Total Depth_____

PRODUCTION

1st 24 hrs. Nat.

1st 24 hrs. after shot-----

Gas..... Cu. Ft.

Dry Hole_____


Abandoned_____

Date _____

4/24, 1917. Carl Scout

Map No. _____ Sec. 17 Twp. 28 R. 4
Well No. 14 _____ Farm _____
Company _____ Company _____

NORTH

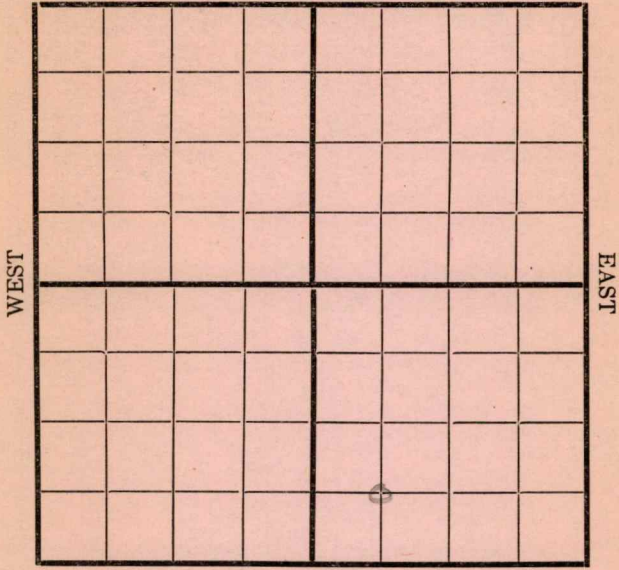


SOUTH

Location _____ Rig Up _____ Drilling and remarks <u>Rigging</u>	RECORD
	Cased _____ in. _____ Ft.
	Sand _____
	Gas _____
	Oil _____
	Total Depth _____
	PRODUCTION
	1st 24 hrs. Nat. _____
	1st 24 hrs. after shot _____
	Gas _____ Cu. Ft.
	Dry Hole _____
	Abandoned _____

Date 5/2, 1917 Carbide Scout

Map No. _____ Sec. 17 Twp. 28 R. 4Well No. 14 Smith _____ FarmEngine _____ Company

NORTH

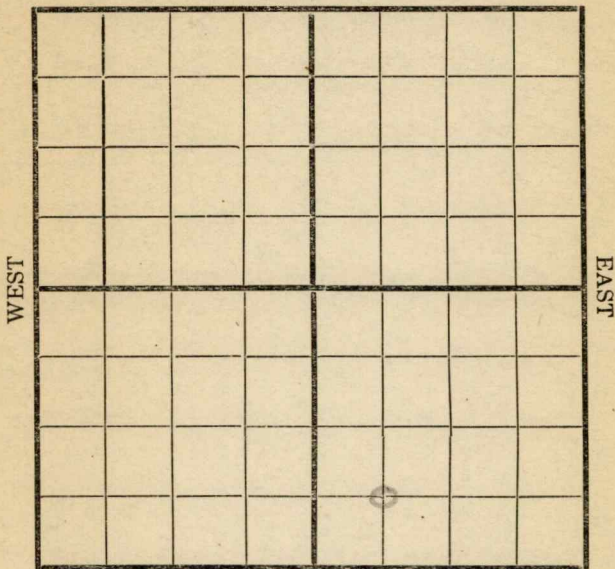

SOUTH

Location _____

Rig Up _____

Drilling and remarks

150

RECORD

Cased _____ in. _____ Ft.

Sand _____

Gas _____

Oil _____

Total Depth _____

PRODUCTION

1st 24 hrs. Nat. _____

1st 24 hrs. after shot _____

Gas _____ Cu. Ft.

Dry Hole _____

Abandoned _____

Date

5/8, 1917 Cordiff Scout

Map No. _____ Sec. 17 Twp. 28 R. 4
 Well No. 14 _____ Farm _____
Engine _____ Company _____

NORTH

WEST

EAST

SOUTH

Location _____

Rig Up _____

Drilling and remarks

640'

RECORD

Cased _____ in. _____ Ft.

Sand _____

Gas _____

Oil _____

Total Depth _____

PRODUCTION

1st 24 hrs. Nat. _____

1st 24 hrs. after shot _____

Gas _____ Cu. Ft.

Dry Hole _____

Abandoned _____


Date

5/25, 1917 Carly Scout

Map No. _____ Sec. 17 Twp. 28 R. 4
 Well No. 14 Smith Farm _____
Engine Company _____

NORTH

WEST

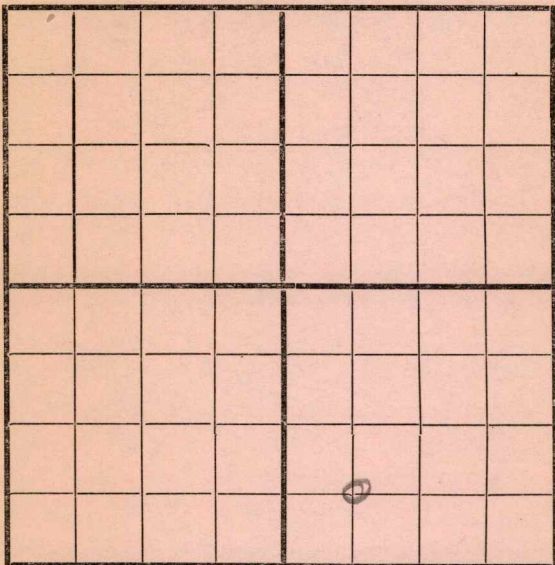

EAST

SOUTH

Location _____
 Rig Up _____
 Drilling and remarks

730

RECORD


Cased _____ in. _____ Ft.
 Sand _____
 Gas _____
 Oil _____
 Total Depth _____

PRODUCTION

1st 24 hrs. Nat. _____
 1st 24 hrs. after shot _____
 Gas _____ Cu. Ft.
 Dry Hole _____
 Abandoned _____

Date Feb 7 1917 C. C. Cady Scout

Map No. _____ Sec. 17 Twp. 28 R. 4
 Well No. 14 Smith Farm _____
Engine Company _____
 NORTH

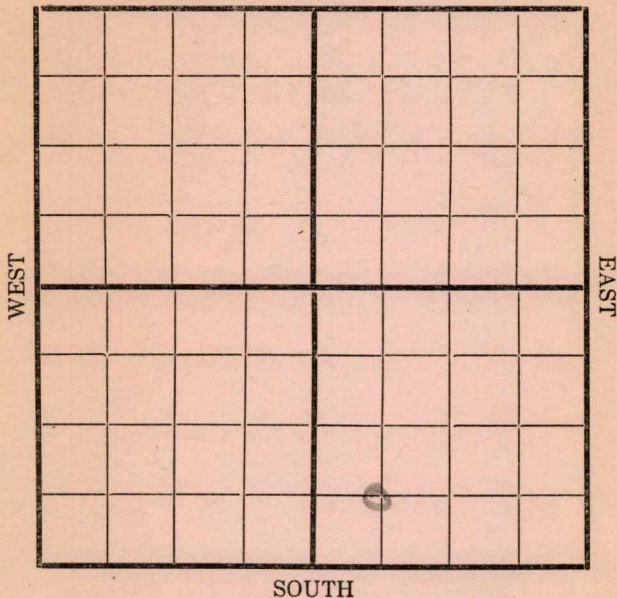

Location _____ Rig Up _____ Drilling and remarks <u>1350</u>	RECORD
	Cased _____ in. _____ Ft.
	Sand _____
	Gas _____
	Oil _____
	Total Depth _____
	PRODUCTION
	1st 24 hrs. Nat. _____
	1st 24 hrs. after shot _____
	Gas _____ Cu. Ft.
	Dry Hole _____
	Abandoned _____

Date 6/8 7 Carley Scout
 _____, 191 _____

Map No. _____ Sec. 17 Twp. 28 R. 4
 Well No. 14 Smith Farm _____
Engine Company _____

NORTH

WEST

EAST

SOUTH

Location _____

Rig Up _____

Drilling and remarks

1692

RECORD

Cased _____ in. _____ Ft.

Sand _____

Gas _____

Oil _____

Total Depth _____

PRODUCTION

1st 24 hrs. Nat. _____

1st 24 hrs. after shot _____

Gas _____ Cu. Ft.

Dry Hole _____

Abandoned _____

Date


6/10, 191 7 Candy Scout

Map No. _____ Sec. 17 Twp. 28 R. 4
 Well No. 14 _____ Farm _____
 _____ Company _____

NORTH

WEST

EAST

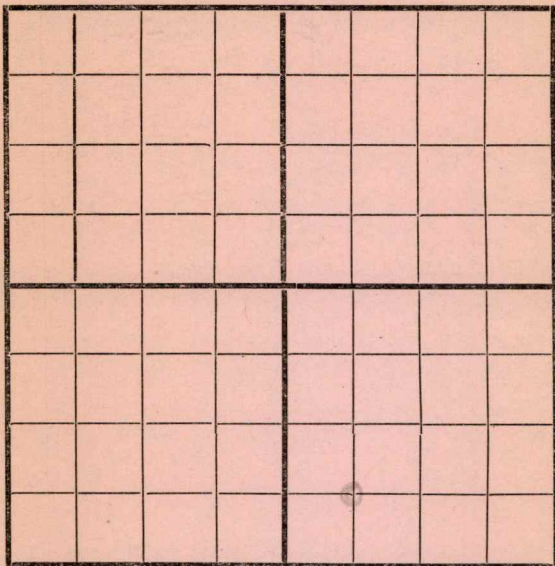

SOUTH

Location _____
 Rig Up _____
 Drilling and remarks _____

RECORD

Cased _____ in. _____ Ft.
 Sand _____
 Gas _____
 Oil _____
 Total Depth _____

PRODUCTION


1st 24 hrs. Nat. _____
 1st 24 hrs. after shot _____
 Gas _____ Cu. Ft.
 Dry Hole _____
 Abandoned _____

Date

6/20/27 _____ 191 _____ Scout

Map No. _____ Sec. 17 Twp. 28 R. 4
 Well No. 14 Smith Farm _____
Engine Company _____

NORTH

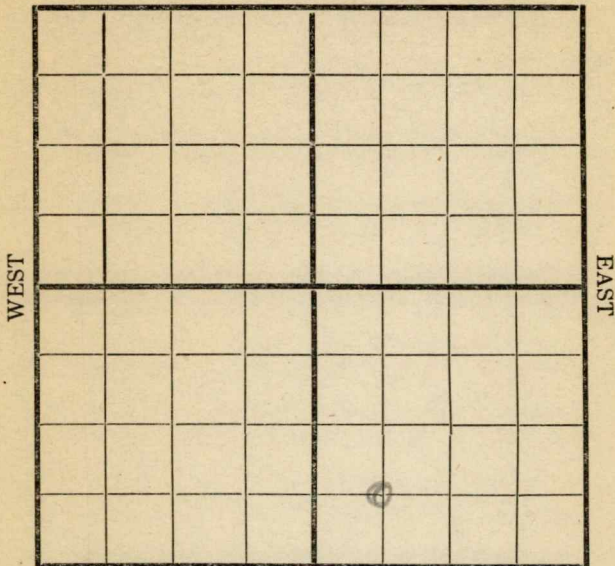

SOUTH

Location _____
 Rig Up _____
 Drilling and remarks _____

2350'

RECORD


Cased _____ in. _____ Ft.
 Sand _____
 Gas _____
 Oil _____
 Total Depth _____

PRODUCTION

1st 24 hrs. Nat. _____
 1st 24 hrs. after shot _____
 Gas _____ Cu. Ft.
 Dry Hole _____
 Abandoned _____

Date 6/27 1917 Candiff Scout

Map No. XII Sec. 17 Twp. 28 R. 4
 Well No. 14 Smith Farm
Empire Company
 NORTH

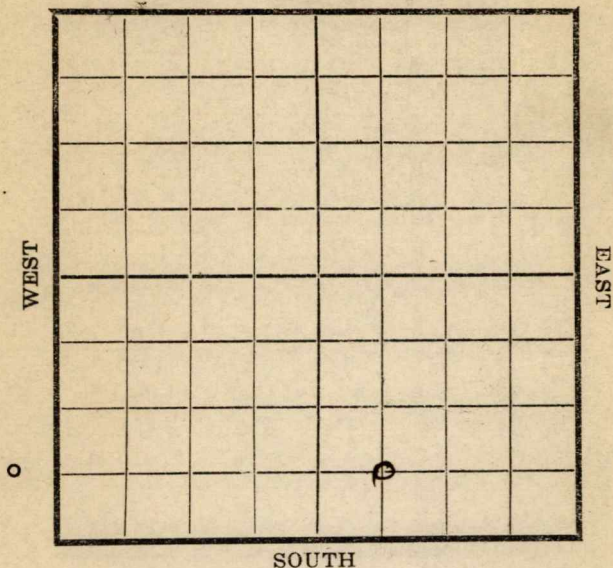

Location -----

Rig Up -----

Drilling and remarks

*This location
is correct.*

RECORD

Cased ----- in. ----- Ft.

Sand -----

Gas -----

Oil -----

Total Depth -----

PRODUCTION

1st 24 hrs. Nat. -----

1st 24 hrs. after shot -----

Gas ----- Cu. Ft.

Dry Hole -----

Abandoned -----

Date

8/10, 1917. Cordiff Scout

Map No. _____ Sec. _____ Twp. _____ R. _____


Well No. _____ Farm _____

_____ Company _____

NORTH

WEST

EAST

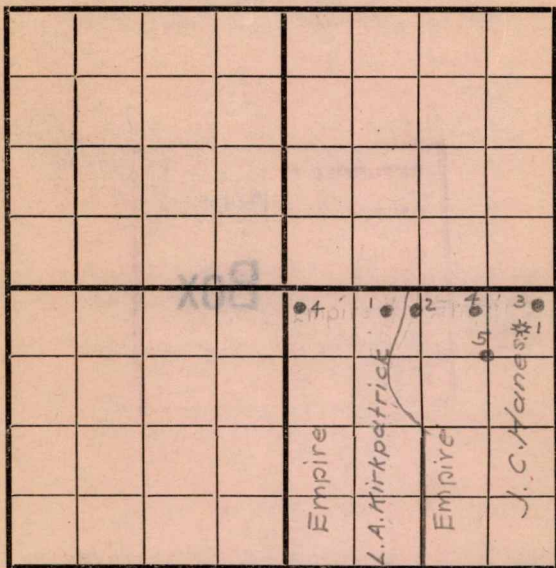

SOUTH

Location _____

Rig Up _____

Drilling and remarks _____

RECORD

Cased _____ in. _____ Ft.

Sand _____

Gas _____

Oil _____

Total Depth _____

PRODUCTION

1st 24 hrs. Nat. _____

1st 24 hrs. after shot _____

Gas _____ Cu. Ft.

Dry Hole _____

Abandoned _____

Date _____

_____, 191____ Scout _____

RETURNED BY _____
ON TRACING _____
ON J. S. C. _____
ON FRANCHISE _____
ON MOOD _____
FILED _____

Box

Run

Box

RETURNED BY
ON TRACING
ON J. S. C. B.
ON FRONT
ON MOOD
FILED

rem. Puro.