


Section 17 Township 28 Range 4 E

Well No. # 1 Kirkpatrick SWD

Company Cities Service

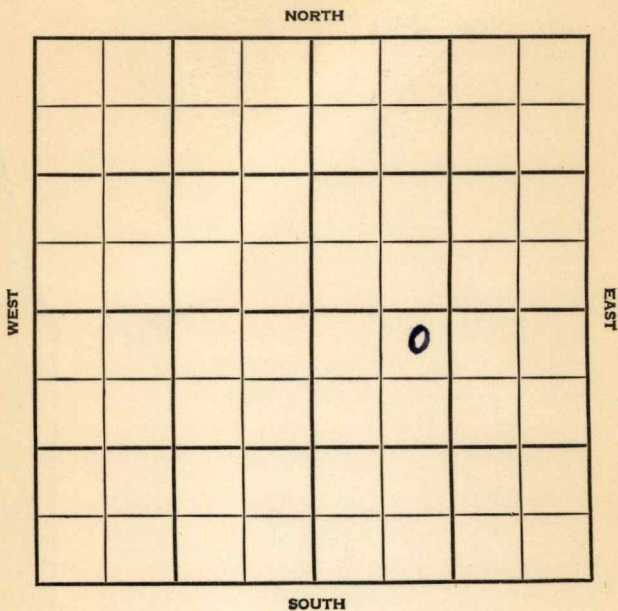

Butler

KANSAS

SEC.	TWP.	R.
17	28	1 E

WELL NO. # 1 Kirkpatrick SWD FARM

COMPANY

CONTRACTOR Cities Service


Augusta

190 Ft. from N. Line

Ft. from S. Line

Ft. from E. Line

845 Ft. from W. Line

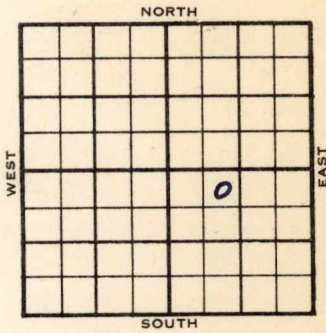

NE NW SE

	ELEVATION	REPORT
1956	1200'	

3/21 7" @ 2487/600 CO to 2844
 S/120 BWPH Comp. for SWD. TD 2844'
 Tops: Dg 1482', Iatan 1613', L. 1685'
 KC 1940', BKC 2152', A. 2362',
 Reagan 2786', Gr. Wash 2792',
 Gr. 2814'

FIRST REPORT
 ←
ABANDONED

County Butler Elev. 1200

Sec. 17 Twp. 28 Rge. 4E

Company Cities Service

Farm Name Kirkpatrick SWD No. 1

TOPS	DEPTH	LOG	DATUM
Anh.			
Tp.			
H.			
Tr.			
Dg.	<u>1482</u>		
Bl. <u>Tatan</u>	<u>1613</u>		
L.	<u>1805</u>		
K.C.	<u>1940</u>		
B.K.C.	<u>2152</u>		
Ce.			
C.			
M.			
M.			
K.			
Mz.			
Me.			
V.			
S.			
S.			
A	<u>2362</u>		
R. <u>eagan</u>	<u>2786</u>		
Pe.			
G. <u>R. wash</u>	<u>2792</u>		
<u>Gr.</u>	<u>2814</u>		
T.P.	<u>2844</u>		

Loc. in Sec. NE NW SE
190' NL
845' WL

Geol. _____
 Contr. _____
 Pool _____
Augusta

~~FIRST REPORT~~
 MAR 21 '56
~~ABANDONED~~

Date Comm. 7" @ 2487/600 CO to 2844 S/ 120 bwph
Comp. for SWD

Co.
Lse.
No.
Sec.
T.
R.