


Section 28 Township 34 Range 3E

Well No. #1 Fishback

Company White & Ellis

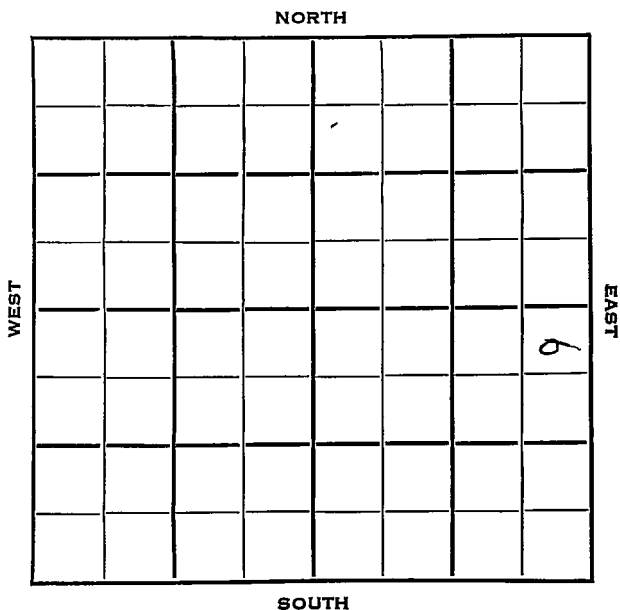

Cowley

Sec. 28 Twp. 34 R. 3E

Well No. #1 Fishback Farm

White & Ellis Company

White & Ellis Contractor

Wildcat


330 Ft. from N. Line

Ft. from S. Line

330 Ft. from E. Line

Ft. from W. Line

NE NE SE

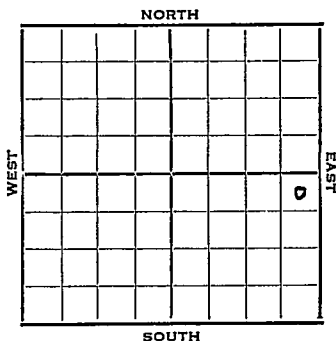

1953

Elev. 1135'

REPORT

2/4

Spud 1-29-53
8" @ 103
Drlg. 1910'

2/18

Spud 1-29-53 D & A TD 3435
8" @ 103 sd 2660 Miss 3393
TD 3435' & D & A

ABANDONED

County **Cowley** State **Kansas**

Sec. **28** (Blk. Twp.) **34** (Sur. Rge.) **3E** Map No.

Operator **White & Ellis**

Well No. **1** Farm **Fishback**

Elev. Location **NE NE SE**

FIRST REPORT					
					o

330 Ft. From **N** Line **SE**

330 Ft. From **E** Line **Quarter**

1st. Report **FEB 4 1953**

Completion

Remarks

White & Ellis - Contr.

Spudding Date **1-29-53**

Drlg. Data **Wildcat**

8" @ 103 drlg. 1910

