


Map No. _____ Sec. 17 Twp. 28 R. 4
 Well No. 12 - Galtston Farm _____
Continental Company

NORTH

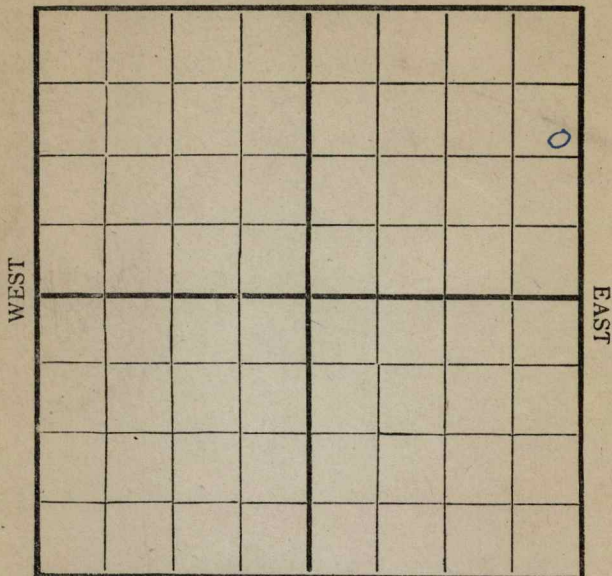

SOUTH

Location _____

Rig Up _____

Drilling Remarks:

Drilling Remarks:

6/30 - 2100'
7/10 - 2300'

RECORD

PRODUCTION

Cased _____ in _____ Ft.
 Sand _____
 Gas _____
 Oil _____
 Total Depth _____

1st 24 hrs. Nat. _____
 1st 24 hrs. after shot _____
 Gas _____ Cu. Ft.
 Dry Hole _____
 Abandoned _____

Map No. _____ Sec. 17 Twp. 28 R. 4
 Well No. 12 Blount Farm _____
Co. K Company _____

NORTH

WEST

EAST

SOUTH

Location _____
 Rig Up _____
 Drilling and remarks _____

2100

✓

RECORD

Cased _____ in. _____ Ft.
 Sand _____
 Gas _____
 Oil _____
 Total Depth _____

PRODUCTION


1st 24 hrs. Nat. _____
 1st 24 hrs. after shot _____
 Gas _____ Cu. Ft.
 Dry Hole _____
 Abandoned _____

Date

6/30, 1916. Blount Scout

Map No. _____ Sec. 17 Twp. 28 R. 4
 Well No. 12 Polston Farm _____
Company Company _____

NORTH

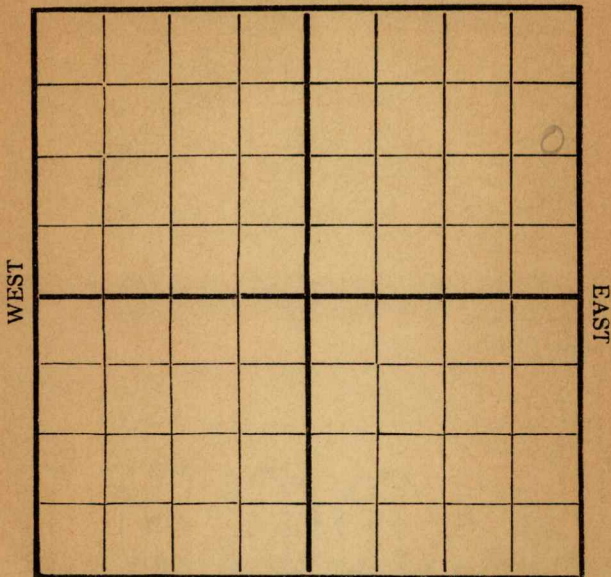

SOUTH

Location _____
 Rig Up _____
 Drilling and remarks _____

2300

RECORD

Cased _____ in. _____ Ft.
 Sand _____
 Gas _____
 Oil _____
 Total Depth _____

PRODUCTION

1st 24 hrs. Nat. _____
 1st 24 hrs. after shot _____
 Gas _____ Cu. Ft.
 Dry Hole _____
 Abandoned _____

Date


7/10, 1916 Scout

Map No. _____ Sec. 17 Twp. 28 R. 4
 Well No. 4 E C Farmer Farm
Empire Company

NORTH

WEST

EAST

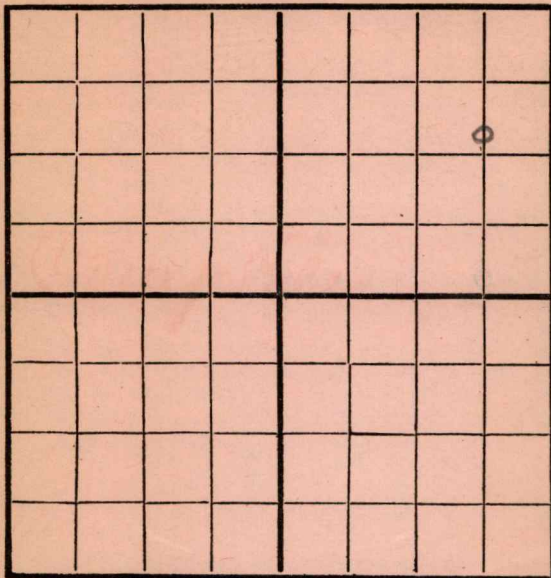

SOUTH

Location _____
 Rig Up _____
 Drilling and remarks _____

Estimated
350 Bbls -

RECORD

Cased _____ in. _____ Ft.
 Sand 2378 - 2418
 Gas _____
 Oil _____
 Total Depth _____


PRODUCTION

1st 24 hrs. Nat. _____
 1st 24 hrs. after shot _____
 Gas _____ Cu. Ft.
 Dry Hole _____
 Abandoned _____

Date 7/15, 1916 C. O. J. Scout

Map No. _____ Sec. 17 Twp. 28 R. 4
Well No. 12 Releston Farm _____
Cont. Empire Company _____

NORTH

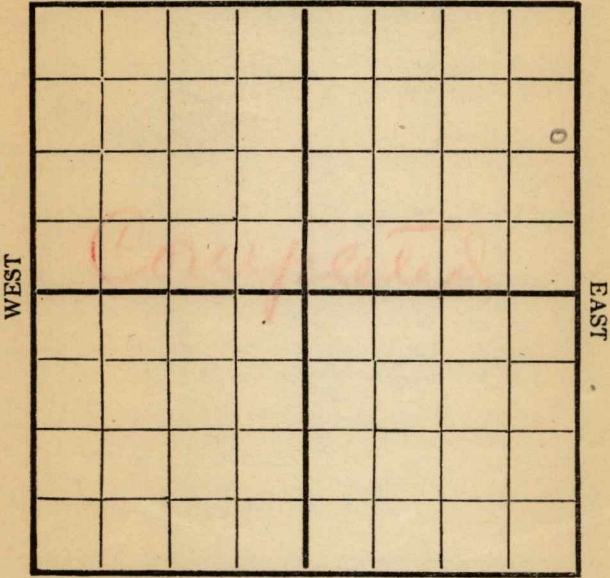

SOUTH

Location _____

Rig Up _____

Drilling and remarks

*Cannot find
any completion
of this well -
you probably
have it on
file. x*

RECORD

Cased _____ in. _____ Ft.
Sand _____
Gas _____
Oil _____
Total Depth _____

PRODUCTION

1st 24 hrs. Nat. _____
1st 24 hrs. after shot _____
Gas _____ Cu. Ft.
Dry Hole _____
Abandoned _____

Date

_____, 191____ *Cardiff* Scout

Map No. 127 Sec. 17 Twp. 28 R. 4
 Well No. 12 Ralston Farm
E. Co. Inc. Company

NORTH

WEST

EAST

(you have completed this as #4 Varner, Please state if #4 Varner is correct)

SOUTH

Location _____
 Rig Up _____
 Drilling and remarks _____

RECORD

Cased _____ in. _____ Ft.
 Sand _____
 Gas _____
 Oil _____
 Total Depth _____

PRODUCTION

1st 24 hrs. Nat. _____
 First 24 hrs. after shot _____
 Gas _____ Cu. Ft.
 Dry Hole _____
 Abandoned _____

Date

_____, 191____ Scout