


Section 28 Township 34 Range 3E
Well No. 3 Jones Estate
Company Grest. Pet.

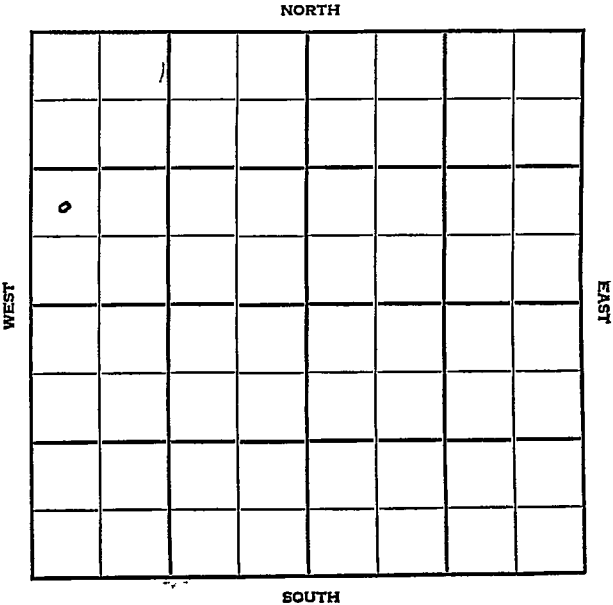

Cowley

SEC.	TWP.	R.
28	34	3 E
WELL NO		
# 3 Jones Estate		
FARM		
COMPANY		
Crest Pet.		
CONTRACTOR		

Crest Pet.

Gibson Pool


Ft. from N. Line

990 Ft. from S. Line

Ft. from E. Line

330 Ft. from W. Line

NW SW NW

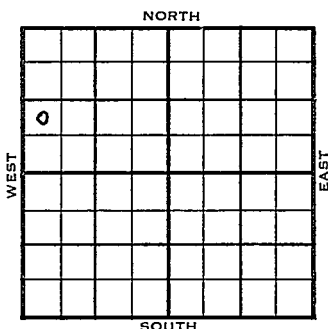

ELEVATION

REPORT

1954

1129'

5/26

Location

10/6

Spud 6-24-54
 D & A TD 3401 8" @ 90
 Stal. 2212 Layton-2665 Bart 3356
 Miss 3388 TD 3401 5" @ 3401 CO to
 3393 94/3366-84 S/3 BO frac.
 S/13 BO 73 BW 4 hr. Hydro. P/30
 BO 60 BWPD FU 1500' fluid 6 BO
 36 hr. Est 10 BOPD 70 BW D & A

ABANDONED

County Cowley State Kansas
 Sec. 28 (Blk.) 34 (Sur.) 3E Map No.
 Operator Crest Pet.
 Well No. 3 Farm Jones Estate
 Elev. Location NW SW NW

0							

990 Ft. From S Line NW330 Ft. From W Line Quarter1st. Report MAY 26 1954

Completion

Remarks

Crest Pet. - Contr.

Spudding Date

Drlg. Data

Gibson PoolLocation

County Cowley State KansasSec. 28 (Blk.) 34 (Sur.) 3E Map No.Operator Crest Pet.Well No. 3 Farm Jones EstateElev. 1129 Location NW SW NW

0					

990 Ft. From S Line NW330 Ft. From W Line Quarter1st. ReportCompletion OCT 6 1954Remarks Gibson PoolCrest Pet. - Contr.Spudding Date 6-24-54Drilg. Data D & A TD 34018" @ 90 Stal. 2212 Layton 2665Bart. 3356 Miss. 3388 TD 34015" @ 3401 CO to 3393 94/ 3366-84S/ 3 bo frac S/ 13 bo 73 bw 4 hr.Hydro. P/ 30 bo 60 bwpdFU 1500' fluid 6 bo 36 hr.Est. 10 bopd 70 bwD & A

FABEN GILSTRAP