


Section 29 Township 34 Range 3E

Well No. 9 Baird

Company Aladdin Petr.

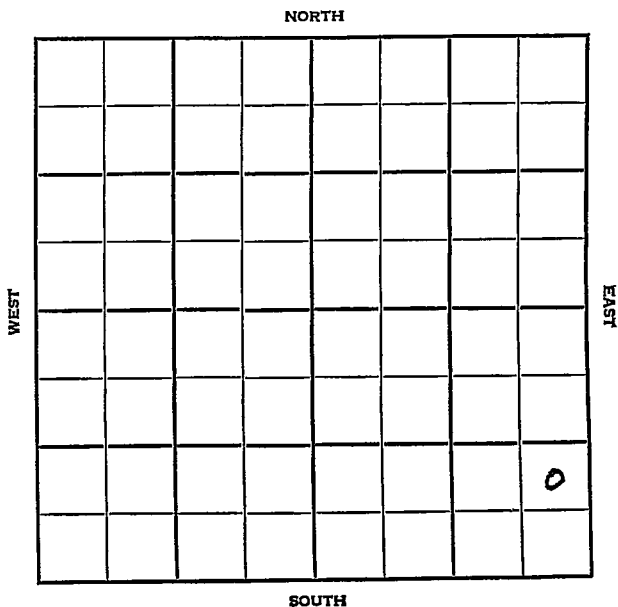

Cowley KANSAS


SEC.	TWP.	R.
29	34	3E

WELL NO. 9 Baird FARM

COMPANY Aladdin Petr.

CONTRACTOR Laura Jane Gibson Pool

_____ Ft. from N. Line
 940 _____ Ft. from S. Line
 330 _____ Ft. from E. Line
 _____ Ft. from W. Line

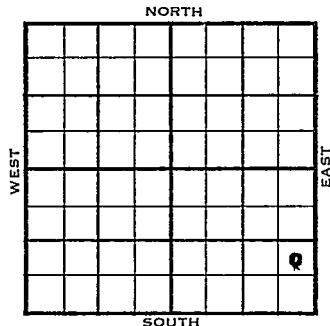

NE SE SE

1954	ELEVATION	REPORT

9/15 Spud 9-10-54
 8" @ 134'
 drlg. 2000'

10/27 Spud 9-10-54 Oilwell TD 3895
 8" @ 134' Layton 2657 KC 2864
 Cleve. 2979 Marm. 3051 Cherokee
 3169' Bart. 3359 Miss 3393
 Simp. 3721 Simp. sd. 3761
 DST 3793-3804 open 1/2 hr rec 230'
 sul. wtr. 1505# Arb. 3893
 TD 3895 5" @ 3800 110/3366-84
 frac. Comp. 290 BOPD 2% wtr.

COMPLETED

