

Map No. _____ Sec. 17 Twp. 28 R. 4Well No. 3- Varnes (5a) Farm _____Big 7 Oil Company _____

NORTH

WEST

EAST

SOUTH

Location _____

Rig Up 10/23

Drilling Remarks:

Drilling Remarks:

290 = 11/9 - 11/14300 = 11/271200 = 12/41450 = 12/11 - 12/181700 = 12/28

RECORD

Cased _____ in _____ Ft.

Sand _____

Gas _____

Oil _____

Total Depth _____

PRODUCTION

1st 24 hrs. Nat. _____

1st 24 hrs. after shot _____

Gas _____ Cu. Ft.

Dry Hole _____


Abandoned _____

Map No. _____ Sec. 17 Twp. 28 R. 4
Well No. 3 corner 65a Farm _____
Big 7 Oil Company _____

NORTH

WEST

EAST

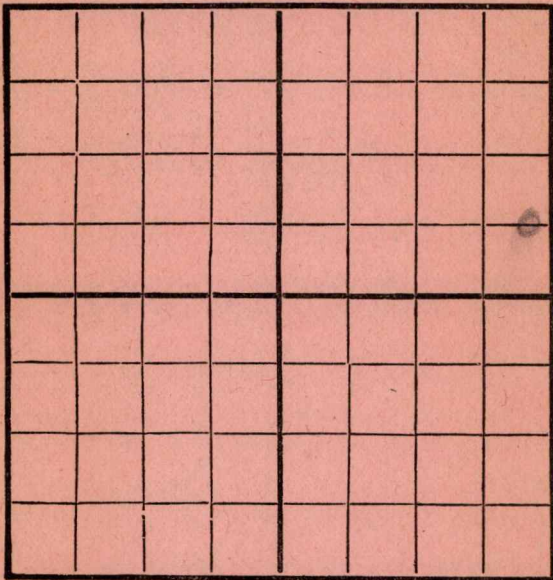

SOUTH

Location _____
Rig Up ☒ _____
Drilling and remarks _____

RECORD

Cased _____ in. _____ Ft.
Sand _____
Gas _____
Oil _____
Total Depth _____

PRODUCTION

1st 24 hrs. Nat. _____
First 24 h. s. after shot _____
Gas _____ Cu. Ft.
Dry Hole _____
Abandoned _____

Date of 33, 1916 Leeco Scout

Map No. _____ Sec. 17 Twp. 28 R. 4

Well No. 3 Farm _____

Big 7 Oil Company _____

NORTH

WEST

EAST

SOUTH

Location _____

Rig Up ☒ _____

Drilling and remarks _____

RECORD

Cased _____ in. _____ Ft.

Sand _____

Gas _____

Oil _____

Total Depth _____

PRODUCTION

1st 24 hrs. Nat. _____

1st 24 hrs. after shot _____

Gas _____ Cu. Ft.

Dry Hole _____


Abandoned _____

Date

1/9, 1916 B. J. Condy Scout

Map No. _____ Sec. 17 Twp. 28 R. 4
 Well No. 3 corner (5a) Farm _____
Big 7 oil Company _____

NORTH

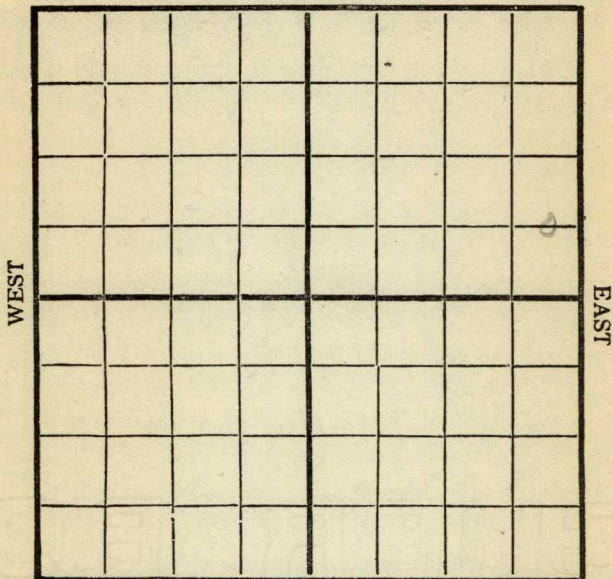

SOUTH

Location _____
 Rig Up ☒ _____
 Drilling and remarks _____

RECORD

Cased _____ in. _____ Ft.
 Sand _____
 Gas _____
 Oil _____
 Total Depth _____

PRODUCTION

1st 24 hrs. Nat. _____
 First 24 h. s. after shot _____
 Gas _____ Cu. Ft.
 Dry Hole _____
 Abandoned _____


Date

8/30, 1916 W. C. C. C. C. Scout

Map No. _____ Sec. 17 Twp. 28 R. 4
 Well No. 3 _____ Farm _____
Big 7 Ave _____ Company _____

NORTH

WEST

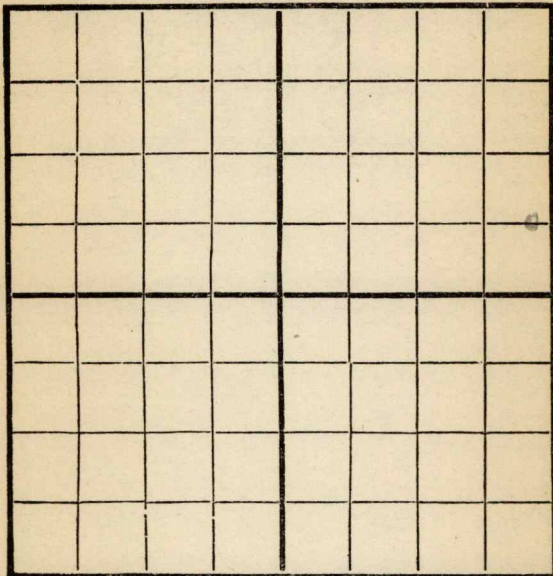

EAST

SOUTH

Location _____
 Rig Up ☒ _____
 Drilling and remarks _____

RECORD

Cased _____ in. _____ Ft.
 Sand _____
 Gas _____
 Oil _____
 Total Depth _____

PRODUCTION

1st 24 hrs. Nat. _____
 First 24 hrs. after shot _____
 Gas _____ Cu. Ft.
 Dry Hole _____
 Abandoned _____

Date


4/14, 1916 Carlyle Scout

Map No. _____ Sec. 17 Twp. 28 R. 4
Well No. 3 _____ Farm _____
Severy Fields _____ Company _____

NORTH

WEST

EAST

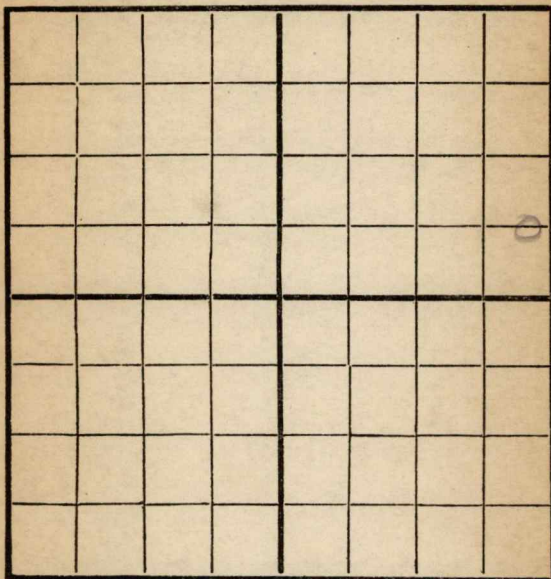

SOUTH

Location _____

Rig Up ☒ _____

Drilling and remarks _____

RECORD

Cased _____ in. _____ Ft.

Sand _____

Gas _____

Oil _____

Total Depth _____

PRODUCTION

1st 24 hrs. Nat. _____

1st 24 hrs. after shot _____

Gas _____ Cu. Ft.

Dry Hole _____

Abandoned _____

Date


11/20 191 6 Conley Scout

Map No. _____ Sec. 17 Twp. 28 R. 4
 Well No. 3 Home (52) Farm _____
Seven Fields Company _____

NORTH

WEST

EAST

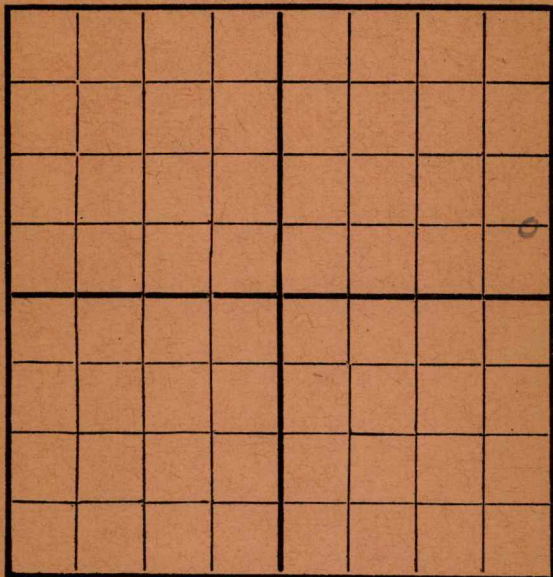

SOUTH

Location _____

Rig Up _____

Drilling and remarks

300

RECORD

Cased _____ in. _____ Ft.

Sand _____

Gas _____

Oil _____

Total Depth _____

PRODUCTION

1st 24 hrs. Nat. _____

1st 24 hrs. after shot _____

Gas _____ Cu. Ft.

Dry Hole _____

Abandoned _____


Date

11/27, 1916 Cordell Scout

Map No. _____ Sec. 17 Twp. 28 R. 4
 Well No. 3 Varner (5a) Farm _____
Seven Fields Company _____

NORTH

WEST

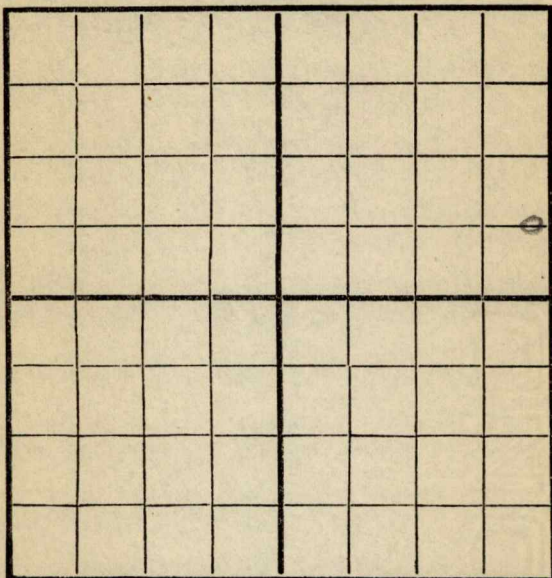

EAST

SOUTH

Location _____

Rig Up _____

Drilling and remarks

1200'

RECORD

Cased _____ in. _____ Ft.

Sand _____

Gas _____

Oil _____

Total Depth _____

PRODUCTION

1st 24 hrs. Nat. _____

1st 24 hrs. after shot _____

Gas _____ Cu. Ft.

Dry Hole _____

Abandoned _____


Date

12/4, 1916, Cardiff Scout

Map No. _____ Sec. 17 Twp. 28 R. 4
 Well No. 3 Harner (J-a) Farm
7 Fields Company

NORTH

WEST

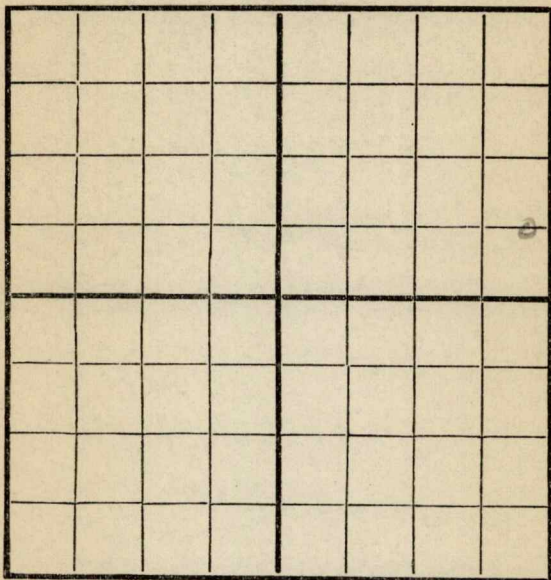

EAST

SOUTH

Location _____

Rig Up _____

Drilling and remarks

1450'

RECORD

Cased _____ in. _____ Ft.

Sand _____

Gas _____

Oil _____

Total Depth _____

PRODUCTION

1st 24 hrs. Nat. _____

1st 24 hrs. after shot _____

Gas _____ Cu. Ft.

Dry Hole _____

Abandoned _____


Date

12/11, 1916 Candys Scout

Map No. _____ Sec. 17 Twp. 28 R. 4
 Well No. 3 Hammer (50) Farm
Seven Fields Company

NORTH

WEST

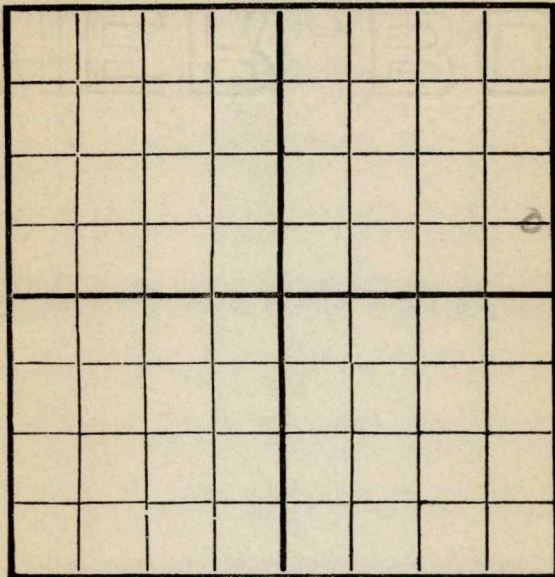

EAST

SOUTH

RECORD

Location _____
 Rig Up _____
 Drilling and remarks _____

Cased _____ in. _____ Ft.
 Sand _____
 Gas _____
 Oil _____
 Total Depth _____

PRODUCTION

1st 24 hrs. Nat. _____
 1st 24 hrs. after shot _____
 Gas _____ Cu. Ft.
 Dry Hole _____
 Abandoned _____

Date

12/8, 1916 Condit Scout

Map No. _____ Sec. 17 Twp. 28 R. 4
 Well No. 3 _____ Farm
Seven Fields Company

NORTH

WEST

EAST

SOUTH

Location _____
 Rig Up _____
 Drilling and remarks

1700

RECORD

Cased _____ in. _____ Ft.
 Sand _____
 Gas _____
 Oil _____
 Total Depth _____

PRODUCTION

1st 24 hrs. Nat. _____
 First 24 hrs. after shot _____
 Gas _____ Cu. Ft.
 Dry Hole _____
 Abandoned _____

Date


12 Feb, 1916

C. C. Cuddy Scout

Map No. _____ Sec. 17 Twp. 28 R. 4
Well No. 3 Farmer (59) Farm
Seven Fields Company

NORTH

WEST

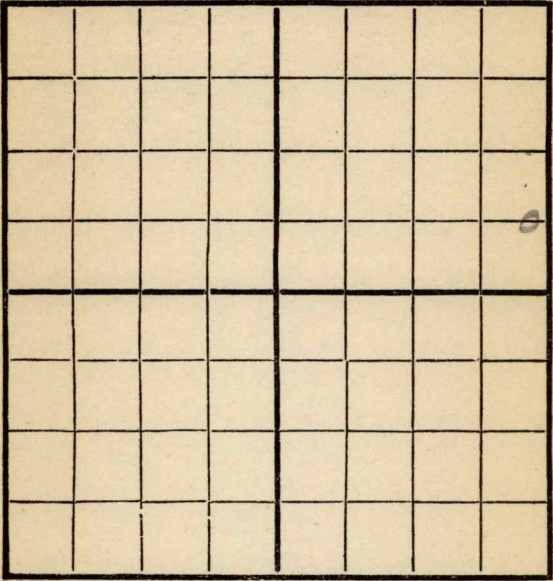

EAST

SOUTH

Location _____
Rig Up _____
Drilling and remarks

2140

RECORD

Cased _____ in. _____ Ft.
Sand _____
Gas _____
Oil _____
Total Depth _____


PRODUCTION

1st 24 hrs. Nat. _____
First 24 hrs. after shot _____
Gas _____ Cu. Ft.
Dry Hole _____
Abandoned _____

Date 1/1, 1917 Candiff Scout

Map No. _____ Sec. 17 Twp. 28 R. 4
 Well No. 3 name (5a) Farm _____
Greenfield oil Company _____

NORTH

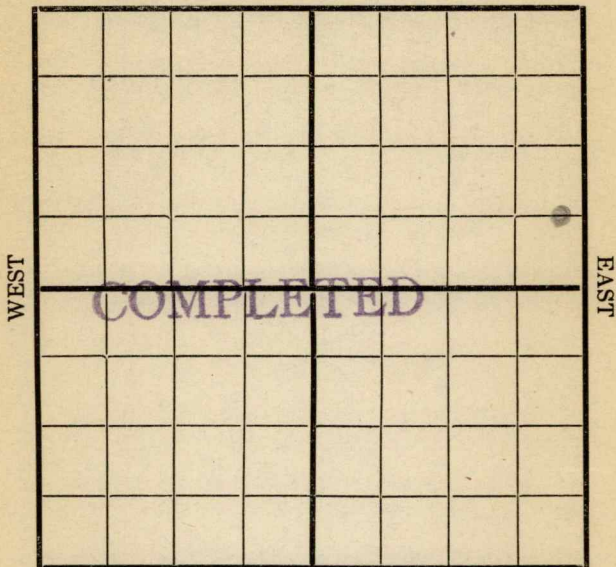

SOUTH

Location _____
 Rig Up _____
 Drilling and remarks _____

RECORD

Cased _____ in. _____ Ft.
 Sand 2442-2452
 Gas _____
 Oil _____
 Total Depth _____

PRODUCTION

1st 24 hrs. Nat. _____
 1st 24 hrs. after shot _____
 Gas _____ Cu. Ft.
 Dry Hole _____
 Abandoned _____

Date

1/8, 1917 Carley Scout