


Map No. _____ Sec. 17 Twp. 28 R. 4
 Well No. 22 Varner Farm _____
Empire Company

NORTH

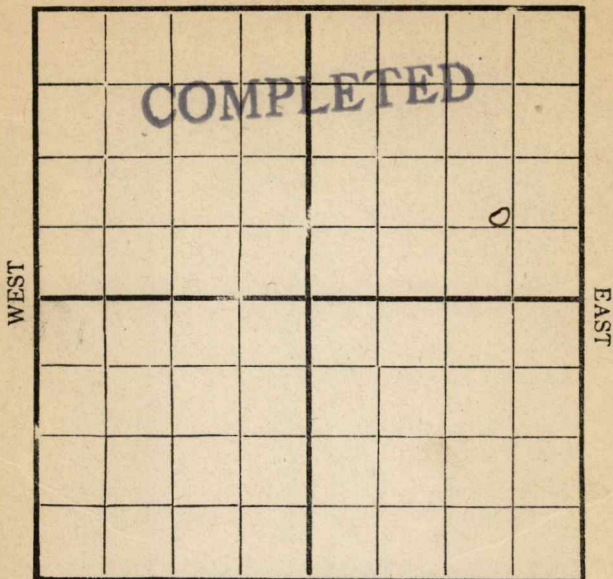

SOUTH

Location _____

Rig Up _____

Drilling Remarks:

Drilling Remarks:


RECORD

PRODUCTION

Cased _____ in _____ Ft.
 Sand _____
 Gas _____
 Oil _____
 Total Depth _____

1st 24 hrs. Nat. _____
 1st 24 hrs. after shot _____
 Gas _____ Cu. Ft.
 Dry Hole _____
 Abandoned _____

Map No. _____ Sec. 17 Twp. 28 R. 4
 Well No. 22 E. @ Verne Farm
Cumple Company
 NORTH

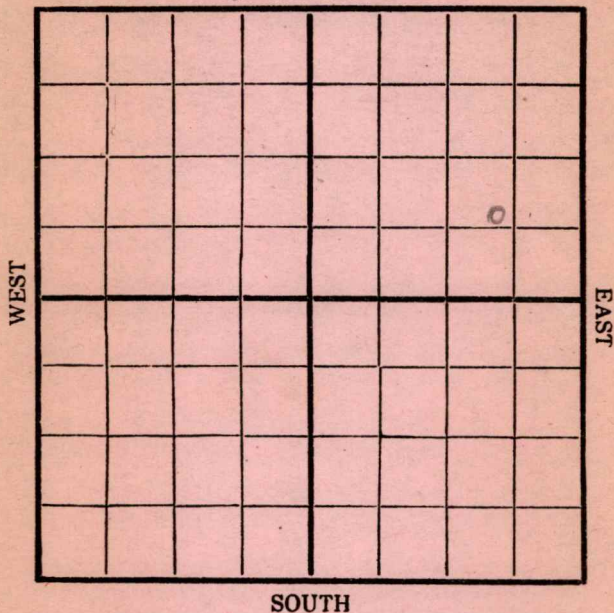

REMARKS:

710 ft N. of South Line
 830 " W. of East Line

FIRST REPORT

Rig up —

Date

3/12/1917 Scout

Map No. _____ Sec. 17 Twp. 28 R. 4
 Well No. 22 Harner Farm
Empire Company

NORTH

WEST

EAST

SOUTH

Location _____
 Rig Up _____
 Drilling and remarks _____

RECORD

Cased _____ in. _____ Ft.
 Sand _____
 Gas _____
 Oil _____
 Total Depth _____

PRODUCTION


1st 24 hrs. Nat. _____
 1st 24 hrs. after shot _____
 Gas _____ Cu. Ft.
 Dry Hole _____
 Abandoned _____

Date

3/19, 1917 Cordell Scout

Map No. _____ Sec. 17 Twp. 28 R. 4
Well No. 22 EC Farmer Farm _____
Campine Company _____

NORTH

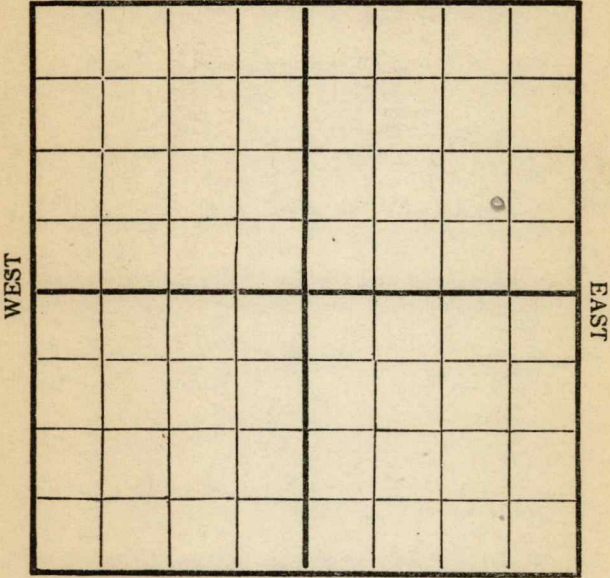

SOUTH

Location _____ Rig Up <u>✓</u> _____ Drilling and remarks _____	RECORD
	Cased _____ in. _____ Ft.
	Sand _____
	Gas _____
	Oil _____
	Total Depth _____
	PRODUCTION
	1st 24 hrs. Nat. _____
	1st 24 hrs. after shot _____
	Gas _____ Cu. Ft.
	Dry Hole _____
	Abandoned _____

Date 3/26, 1912 Campine Scout

Map No. _____ Sec. 17 Twp. 28 R. 4Well No. 22 _____ Farm _____Cumprine _____ Company _____

NORTH

WEST

EAST

SOUTH

Location _____

Rig Up _____

Drilling and remarks

RECORD
Cased _____ in. _____ Ft.

Sand _____

Gas _____

Oil _____

Total Depth _____

PRODUCTION

1st 24 hrs. Nat. _____

First 24 hrs. after shot _____

Gas _____ Cu. Ft.

Dry Hole _____

Abandoned _____

Date

4/4, 1917. Cumprine _____ Scout

Map No. _____ Sec. 17 Twp. 28 R. 4
 Well No. 22 Warner Farm _____
Cummins Company _____

NORTH

WEST

EAST

SOUTH

Location _____
 Rig Up _____
 Drilling and remarks

835'

RECORD

Cased _____ in. _____ Ft.
 Sand _____
 Gas _____
 Oil _____
 Total Depth _____


PRODUCTION

1st 24 hrs. Nat. _____
 1st 24 hrs. after shot _____
 Gas _____ Cu. Ft.
 Dry Hole _____
 Abandoned _____

Date

4/10, 1917 C. C. Coffey Scout

Map No. _____ Sec. 17 Twp. 28 R. 4
 Well No. 22 _____ Farm
Engine _____ Company
 NORTH

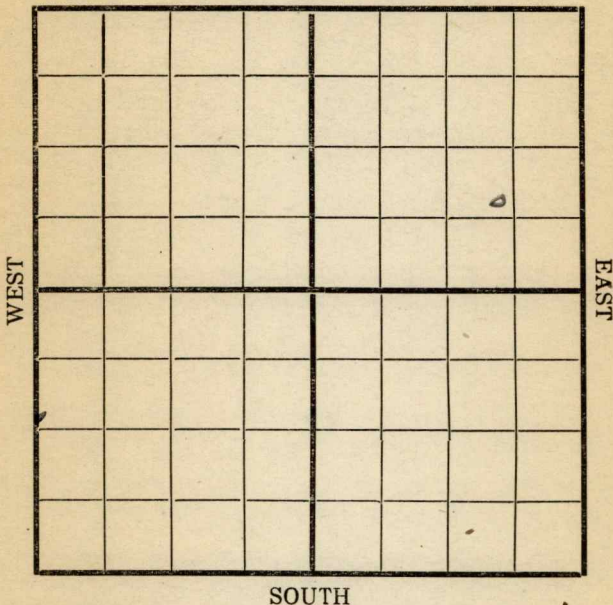

SOUTH

Location _____
 Rig Up _____
 Drilling and remarks

1335

RECORD

Cased _____ in. _____ Ft.
 Sand _____
 Gas _____
 Oil _____
 Total Depth _____

PRODUCTION

1st 24 hrs. Nat. _____
 1st 24 hrs. after shot _____
 Gas _____ Cu. Ft.
 Dry Hole _____
 Abandoned _____

Date 4/17, 1917 Condy Scout

Map No. _____ Sec. 17 Twp. 28 R. 4Well No. 22 Farm _____
Engine Company _____

NORTH

WEST

EAST

SOUTH

Location _____

Rig Up _____

Drilling and remarks

RECORD

Cased _____ in. _____ Ft.

Sand _____

Gas _____

Oil _____

Total Depth _____

PRODUCTION

1st 24 hrs. Nat. _____

1st 24 hrs. after shot _____

Gas _____ Cu. Ft.

Dry Hole _____

Abandoned _____

Date


4/24, 1917 Carly Scout

Map No. _____ Sec. 17 Twp. 28 R. 4
 Well No. 22 Farmer Farm _____
Engine Company _____

NORTH

WEST

EAST

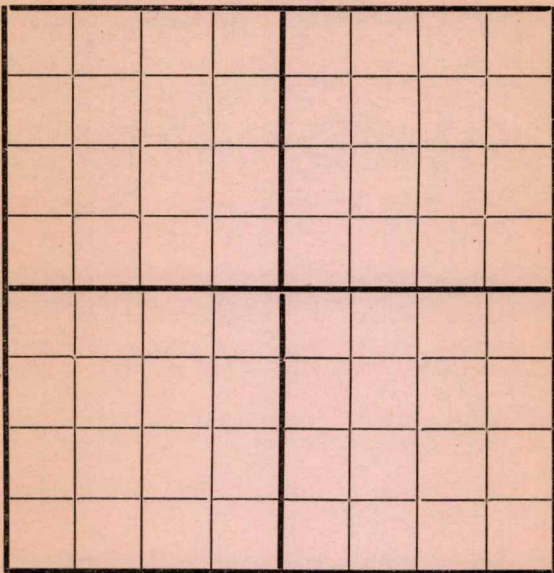

SOUTH

Location _____
 Rig Up _____
 Drilling and remarks _____

2175

RECORD

Cased _____ in. _____ Ft.
 Sand _____
 Gas _____
 Oil _____
 Total Depth _____


PRODUCTION

1st 24 hrs. Nat. _____
 1st 24 hrs. after shot _____
 Gas _____ Cu. Ft.
 Dry Hole _____
 Abandoned _____

Date 5/2, 1917 Carly Scout

Map No. _____ Sec. 17 Twp. 28 R. 4
 Well No. 22 Farmer Farm
Engine Company

NORTH

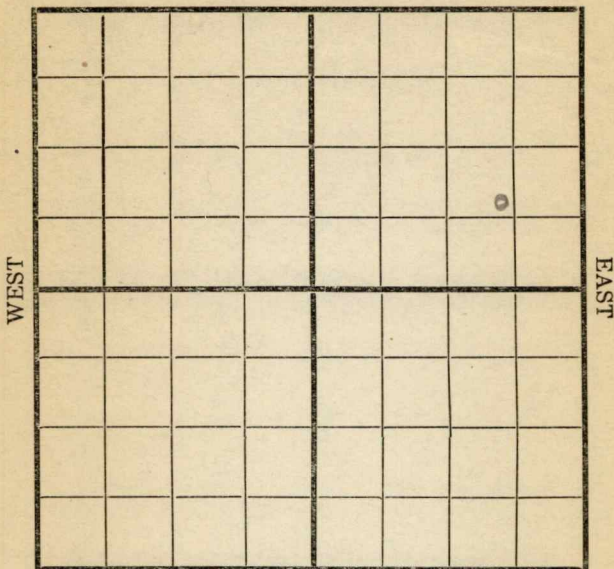

SOUTH

Location _____

Rig Up _____

Drilling and remarks

Log 2370

RECORD

Cased _____ in. _____ Ft.

Sand _____

Gas _____

Oil _____

Total Depth _____

PRODUCTION

1st 24 hrs. Nat. _____

1st 24 hrs. after shot _____

Gas _____ Cu. Ft.

Dry Hole _____

Abandoned _____

Date

5/8, 191 *7* *Cardiff* Scout

Map No. _____ Sec. 17 Twp. 28 R. 4
 Well No. 22 Kanner Farm _____
Engine Company _____

NORTH

WEST

EAST

COMPLETED

SOUTH

Location _____

Rig Up _____

Drilling and remarks

Est at
90 Bbls

RECORD

Cased _____ in. _____ Ft.

Sand 2370-2394

Gas _____

Oil _____

Total Depth _____

PRODUCTION

1st 24 hrs. Nat. _____

1st 24 hrs. after shot _____

Gas _____ Cu. Ft.

Dry Hole _____

Abandoned _____

Date

5/25-2 191 Car. Co. Scout