

DX 78-1

Cowley;


KANSAS

Section 29 Township 34 Range 3EWell No. #13 BairdCompany Azaddin Pet.

NORTH

WEST

EAST

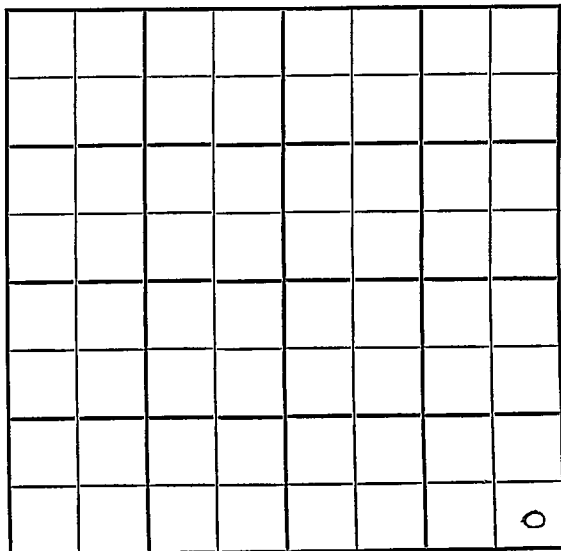

SOUTH

KANSAS

WELL NO. _____

13 Baird _____ FARM

COMPANY _____

CONTRACTOR	
Crowe	
Gibson Pool	NORTH

Crowe

Gibson Pool


_____ Ft. from N. Line

330' Ft. from S. Line

330' Ft. from E. Line

_____ Ft. from W. Line

SE SE SE

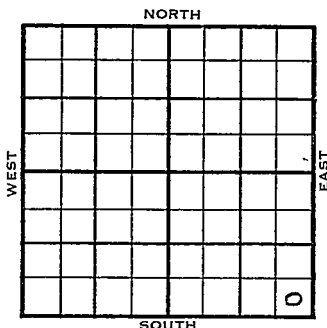

1955

ELEVATION

1128:

REPORT

6/1

M I R

8/10

Comm: 6-1-55

8 5/8" @139/135 5 1/2" @3376/100

CO to 3383 frac P/10 boph P/60 bo

6 hr. Comp 77 bopd. 56% wtr.

Tp Layton: 2657 1529

KC	2857	1729
----	------	------

BKC Cleve.	2986	1858
------------	------	------

Ce. Oswego	3027	1929
------------	------	------

C. Ce.	3174	2046
--------	------	------

M. Bart	3371	2243
---------	------	------

TD: 3397 COM

COMPLETED

County	Cowley			State	Kansas
Sec.	29	(Blk. Twp.)	34	(Sur. Rge.)	3E Map No.

Sec. 29 (Blk. Twp.) 34 (Sur. Rge.) 3E Map No.

Operator Aladdin Pet.

Well No. 13 Farm Baird

Elev.	Location	SE	SE	SE
-------	----------	----	----	----

330 Ft. From S Line SE

330 Ft. From E Line Quarter

1st. Report JUN 1 1955

Completion

Remarks

Crowe Drlg. - Contr.

Spudding Date

Drlg. Data Gibson Pool

M T R

County Cowley Elev. 1128
 Sec. 29 Twp. 34 Rge. 3E
 Company Aladdin Pet.
 Farm Name Baird No. 13

TOPS	DEPTH	LOG	DATUM
Anh.			
Tp. <u>Layton</u>	<u>2657</u>		<u>1529</u>
H.			
Tr.			
Dg.			
BL.			
L.			
K.C.	<u>2857</u>		<u>1729</u>
B.K.C. <u>Clava</u>	<u>2986</u>		<u>1858</u>
Ce. <u>Osuaga</u>	<u>3057</u>		<u>1929</u>
C. <u>Ce</u>	<u>3174</u>		<u>2048</u>
M. <u>Rant</u>	<u>3279</u>		<u>2243</u>
M.			
K.			
Mz.			
Mq.			
V.			
S.			
S.			
A.			
R.			
PE.			
G.			
T.D.	<u>3297</u>		

Loc. in Sec. _____

SE SE SE

Geol. _____

Contr. _____

Crowe Drlg.

Pool _____

Gibson

COMPLETE

Date Comm. 6-1-55 AUG 10 1955

8 5/8" @ 139/135 5 1/2" @ 3376/100

CO to 3383 frac P/ 10 boph

P/ 60 bo 6 hr. Comp. 77 bopd 50% wtr.