


Section 29 Township 34 Range 3 E

Well No. # 5 Baird (A)

Company Aladdin Pet.

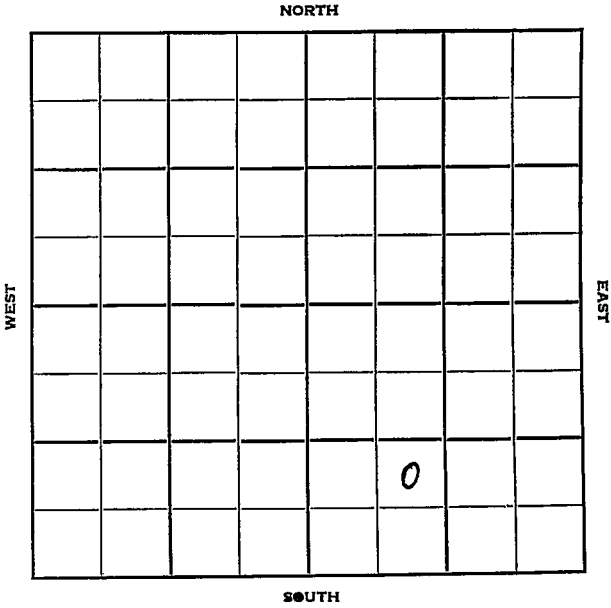

Sec. 29 Twp. 34 R. 3 E

Well No. # 5 Baird (A) Farm

Aladdin Pet. Company

Contractor

Bibson


_____ Ft. from N. Line

990 Ft. from S. Line

_____ Ft. from E. Line

990 Ft. from W. Line

NE SW SE

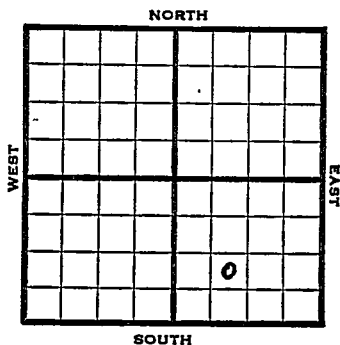

1952

Elev. 1132' REPORT

8/13

Cellar & Pits

10/8

Spud 8-15-52

Oil well TD 3396' 8" @ 355

Severy sd 1454' Bart. 3378'

TD 3396 5" @ 3378 CO to 3396'

Hydro. F/15 BOPH

Comp. 484 BOPD 2% wtr.

COMPLETED

County **Cowley** State **Kansas**

Sec. **29** (Blk. **34** (Sur. **SE** Map No. **3E**) (Twp. **34** (Rqe. **3E**))

Operator **Aladdin Pet.**

Well No. **5** Farm **Baird (A)**

Elev. _____ Location **NE SW SE**

FIRST REPORT

990 Ft. From **S** Line **SE**

990 Ft. From **W** Line **Quarter**

1st. Report **AUG 13 1952**

Completion _____

Remarks _____

Spudding Date _____

Drlg. Data **Gibson**

Cellar & pits

J. G. MCGEHEE

