

Map No. _____ Sec. 17 Twp. 28 R. 4
Well No. 26 Varner Farm _____
Empire Company

NORTH

WEST

EAST

SOUTH

Location _____

Rig Up _____

Drilling Remarks:

Drilling Remarks:

RECORD

PRODUCTION

Cased _____ in. _____ ft.

1st 24 hrs. Nat. _____

Sand _____

1st 24 h's. after shot _____

Gas _____

Gas _____ cu. ft

Oil _____

Dry Hole _____


Total Depth _____

Abandoned _____

Map No. _____ Sec. 17 Twp. 28 R. 4
 Well No. 26. E. C. Varner Farm
Company Company

NORTH

WEST

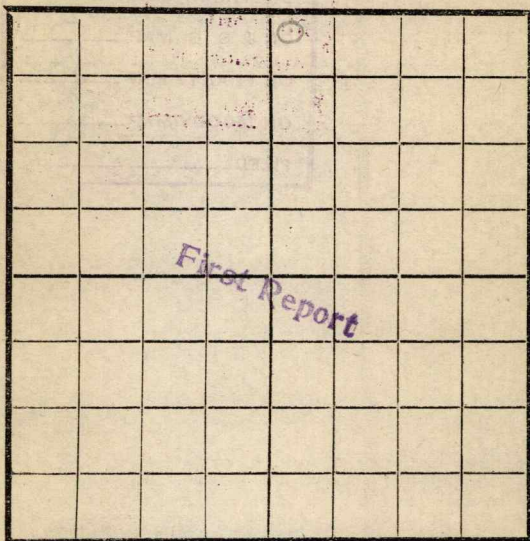

EAST

SOUTH

Location _____

Rig Up _____

Drilling and remarks

Timbers

RECORD

Cased _____ in. _____ Ft.

Sand _____

Gas _____

Oil _____

Total Depth _____

PRODUCTION

1st 24 hrs. Nat. _____

1st 24 hrs. after shot _____

Gas _____ Cu. Ft.

Dry Hole _____

Abandoned _____

Date

8-27-1917

Lantz

Scout


Map No. _____ Sec. 17 Twp. 28 R. 4

Well No. 26 Farmer Farm _____

Engine Company _____

NORTH

WEST

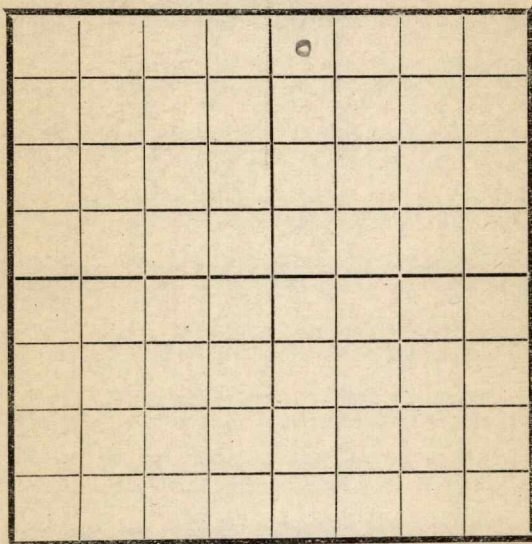

SOUTH

Location _____

Rig Up _____

Drilling and remarks

1400

RECORD

Cased _____ in _____ Ft

Sand _____

Gas _____

Oil _____

Total Depth _____

PRODUCTION

1st 24 hrs. Nat. _____

1st 24 hrs. after shot _____

Gas _____ Cu. Ft


Dry Hole _____

Abandoned _____

Date

10/9, 1912 Landry Scout _____

Map No. _____ Sec. 17 Twp. 28 R. 4
Well No. 26 Harmer Farm _____
Engine Company _____
NORTH

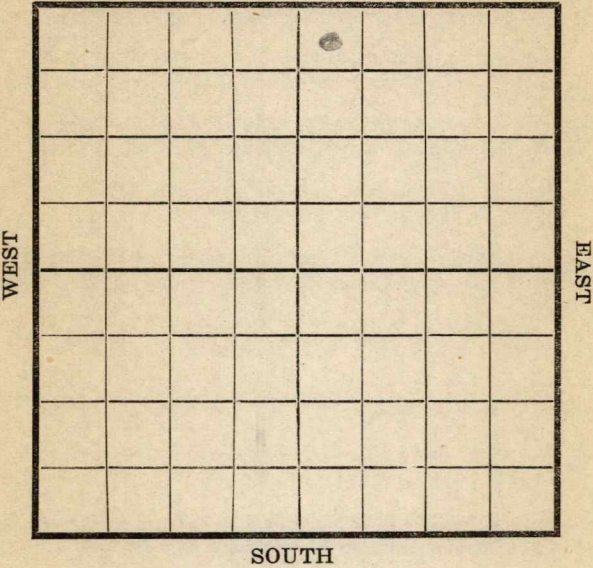

Location _____
Rig Up _____
Drilling and remarks
1850

RECORD
Cased _____ in. _____ Ft.
Sand _____
Gas _____
Oil _____
Total Depth _____

PRODUCTION
1st 24 hrs. Nat. _____
1st 24 hrs. after shot _____
Gas _____ Cu. Ft.
Dry Hole _____
Abandoned _____


Date 10/17, 1917 Gandy Scout _____

Map No. _____ Sec. 17 Twp. 28 R. 4Well No. 36 _____ Farm _____

_____ Company _____

NORTH

WEST

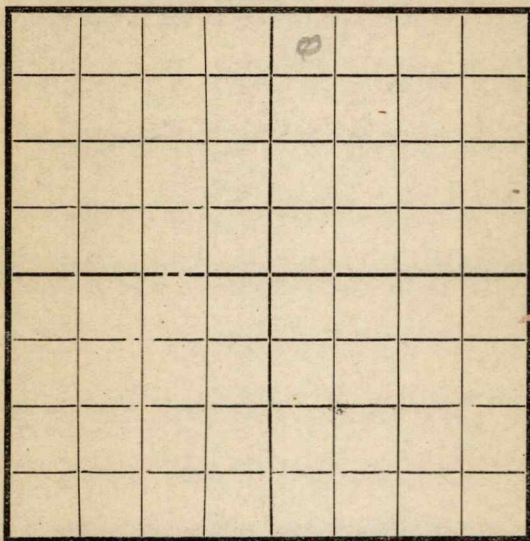

EAST

SOUTH

Location _____

Rig Up _____

Drilling and remarks

2050

RECORD

Cased _____ in. _____ Ft.

Sand _____

Gas _____

Oil _____

Total Depth _____

PRODUCTION

1st 24 hrs. Nat. _____

1st 24 hrs. after shot _____

Gas _____ Cu. Ft.

Dry Hole _____

Abandoned _____


Date

10/24/1917 _____ Scout

Map No. _____ Sec. 17 Twp. 28 R. 4
 Well No. 26 Farmer Farm
Empire Company

NORTH

WEST

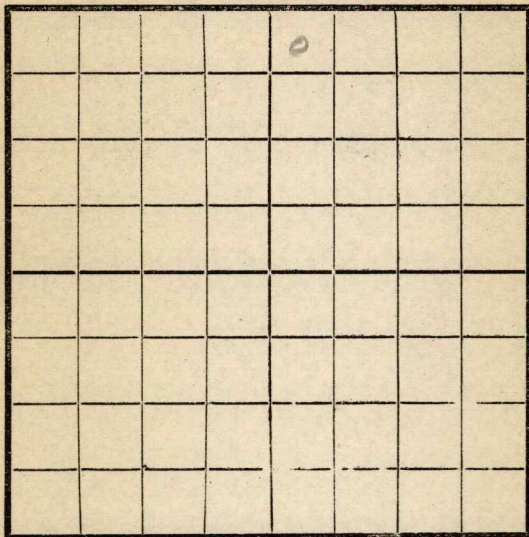

EAST

SOUTH

Location _____
 Rig Up _____
 Drilling and remarks

2225

RECORD

Cased _____ in. _____ Ft.
 Sand _____
 Gas _____
 Oil _____
 Total Depth _____

PRODUCTION

1st 24 hrs. Nat. _____
 1st 24 hrs. after shot _____
 Gas _____ Cu. Ft.
 Dry Hole _____
 Abandoned _____

Date

10/31, 1917 Campbell Scout


Map No. _____ Sec. 17 Twp. 28 R. 4

Well No. 26 E C Farmer Farm

Engine Company

NORTH

WEST

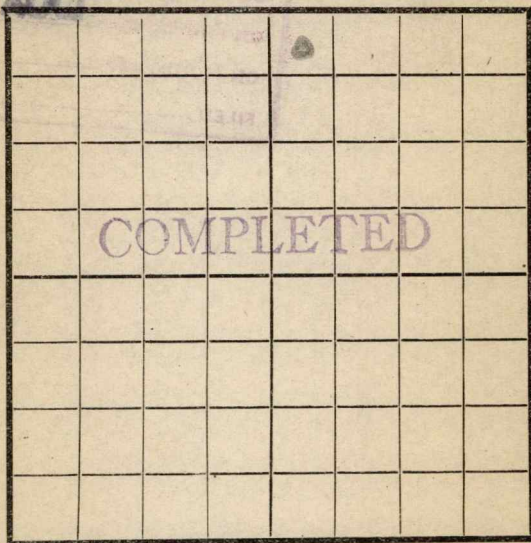

EAST

SOUTH

RECORD

Location _____

Cased _____ in _____ Ft.

Rig Up _____

Sand 2404-2413

Drilling and remarks

Gas _____

Oil _____

Total Depth _____

PRODUCTION

1st 24 hrs. Nat. _____

1st 24 hrs. after shot _____

Gas _____ Cu. Ft.

Dry Hole _____

Abandoned _____

Date

11-7, 1917 Candyp Scout