


Section 29 Township 34 Range 3E

Well No. #6 Baird (A)

Company Aladdin

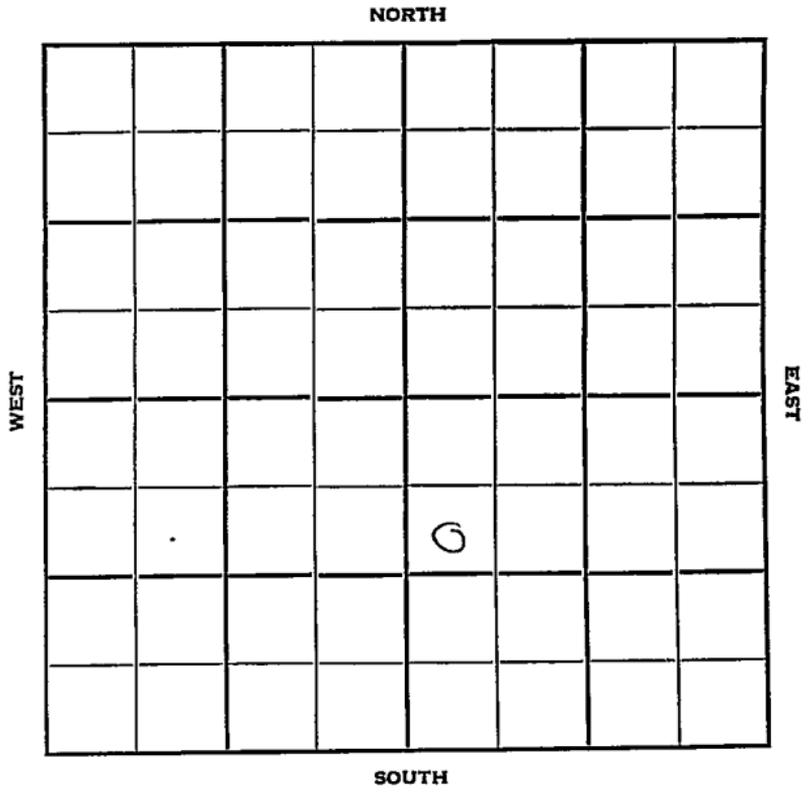

Cowley

KANSAS ✓

Sec. 29 Twp. 34 R. 3 E

Well No. # 6 Baird (A) Farm

Aladdin Company

Crowe Contractor


990 Ft. from N. Line

_____ Ft. from S. Line

_____ Ft. from E. Line

330 Ft. from W. Line

SW NW SE

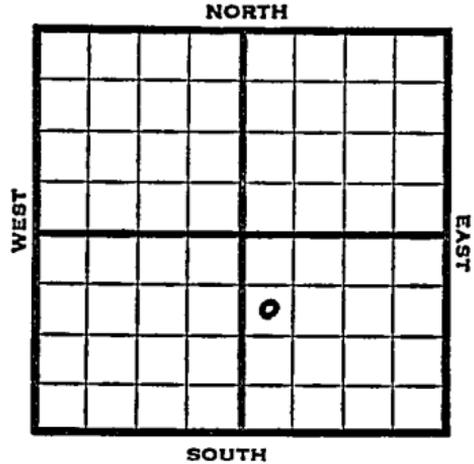

1952

Elev. 1143' ~ REPORT

8/27

Location

10/8

Spud 8-27-52

Oil well TD 3413' 8" @ 140

Bart. 3380' TD 3413' 5" @ 3380

CO to 3413 S¹/₄ BOPH Hydro.

F/6 BOPH

Comp. 432 BOPD 6% wtr.

COMPLETED

