


Map No. _____ Sec. 17 Twp. 28 R. 4 (log)
 Well No. 31 Varner Farm _____
Empire Company

NORTH

WEST

EAST

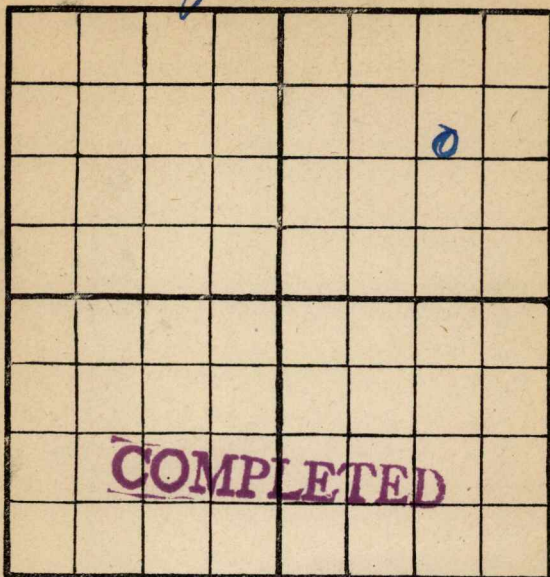

SOUTH

Location _____

Rig Up _____

Drilling Remarks:

Drilling Remarks:

RECORD

PRODUCTION

Cased _____ in. _____ ft.
 Sand _____
 Gas _____
 Oil _____
 Total Depth _____

1st 24 hrs. Nat. _____
 1st 24 hrs. after shot _____
 Gas _____ cu. ft
 Dry Hole _____
 Abandoned _____

Map No. 1002 K 11 Sec. 17 Twp. 28 R. 4Well No. 31 FarmEmpire Company

NORTH

WEST

EAST

SOUTH

Location -----

Rig Up ☒ -----

Drilling and remarks

1400 E 7 2 2
1200 S 7 2 2

RECORD

Cased ----- in. ----- Ft.

Sand -----

Gas -----

Oil -----

Total Depth -----

PRODUCTION

1st 24 hrs. Nat. -----

1st 24 hrs. after shot -----

Gas ----- Cu. Ft.

Dry Hole -----

Abandoned -----

FIRST REPORT

Date


4/26, 1918 P. C. C. C. Scout

Map No. _____ Sec. 17 Twp. 28 R. 4Well No. 31 Farmer Farm _____

Company _____

NORTH

WEST

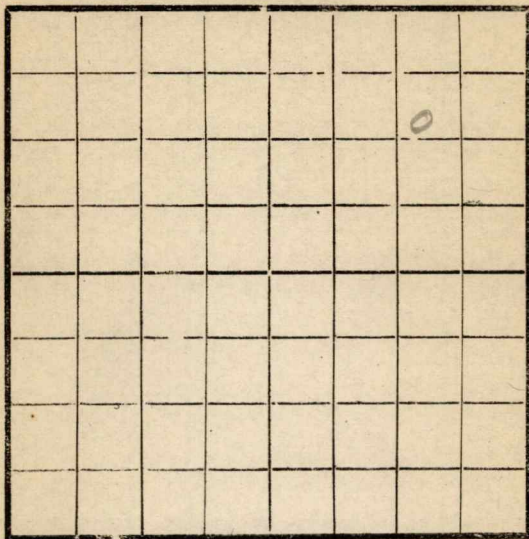

EAST

SOUTH

Location _____

Rig Up ☒ _____

Drilling and remarks

This is going to be a deep test - Expect to go to 4500'

RECORD

Cased _____ in. _____ Ft.

Sand _____

Gas _____

Oil _____

Total Depth _____

PRODUCTION

1st 24 hrs. Nat. _____

1st 24 hrs. after shot _____

Gas _____ Cu. Ft.

Dry Hole _____

Abandoned _____

Date

5/15, 1918 S. Cordery Scout


Map No. _____ Sec. 17 Twp. 28 R. 4

Well No. 31 Harner Farm

Ameyne Company

NORTH

WEST

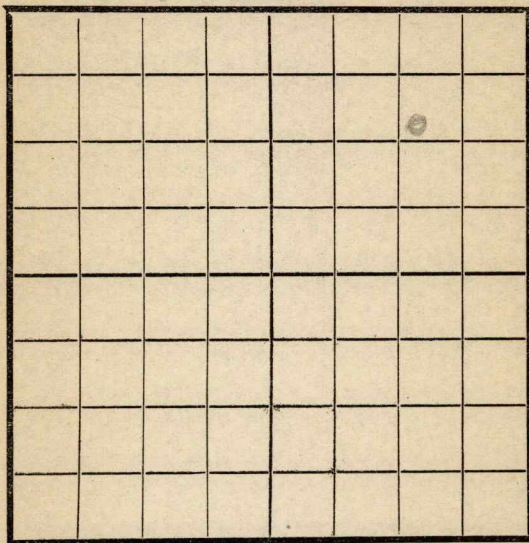

EAST

SOUTH

Location _____

Rig Up _____

Drilling and remarks

RECORD

Cased _____ in _____ Ft.

Sand _____

Gas _____

Oil _____

Total Depth _____

PRODUCTION

1st 24 hrs. Nat. _____

1st 24 hrs. after shot _____

Gas _____ Cu. Ft.

Dry Hole _____

Abandoned _____

Date

5/39, 1911 J. Carley Scout

Map No. _____ Sec. 17 Twp. 28 R. 4Well No. 31 Farmer

_____ Company

_____ Contractor

NORTH

WEST

EAST

SOUTH

Location _____

Rig up _____

Drilling and Remarks:

RECORD

Cased _____ in., _____ ft.

Sand _____

Gas _____

Oil _____

Total Depth _____

PRODUCTION

1st 24 hrs. Nat. _____

1st 24 hrs. after shot _____

Gas _____ Cu. Ft.

Dry Hole _____

Abandoned _____

Date

191

Scout

Map No. _____ Sec. 17 Twp. 28 R. 4Well No. 31 _____

_____ Company

_____ Contractor

NORTH

WEST

EAST

SOUTH

Location _____

Rig up _____

Drilling and Remarks:

RECORD

Cased _____ in., _____ ft.

Sand _____

Gas _____

Oil _____

Total Depth _____

PRODUCTION

1st 24 hrs. Nat. _____

1st 24 hrs. after shot _____

Gas _____ Cu. Ft.


Dry Hole _____

Abandoned _____

Date

6/12 191 8 Candry Scout

Map No. _____ Sec. 17 Twp. 28 R. 4
 Well No. 31 Harner
Engine _____ Company _____
 _____ Contractor _____

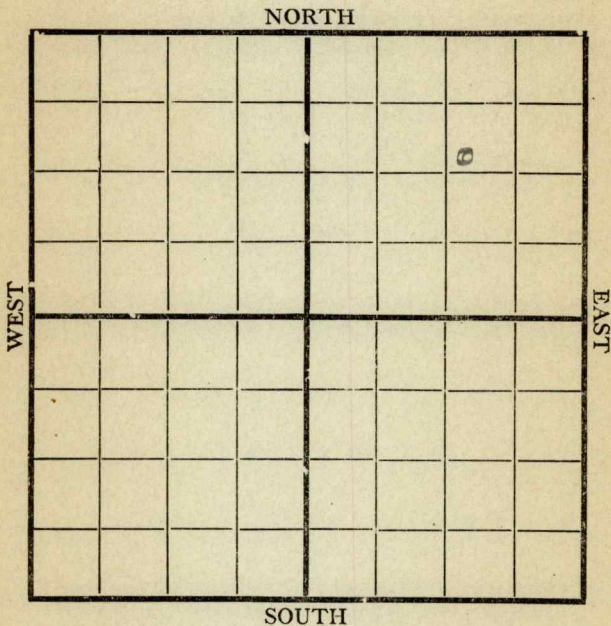

Location _____
 Rig up _____
 Drilling and Remarks:

720

RECORD

Cased _____ in., _____ ft.
 Sand _____
 Gas _____
 Oil _____
 Total Depth _____

PRODUCTION

1st 24 hrs. Nat. _____
 1st 24 hrs. after shot _____
 Gas _____ Cu. Ft.
 Dry Hole _____
 Abandoned _____

Date 6/19 1918 C. C. Cady Scout

Map No. _____ Sec. 17 Twp. 28 R. 4Well No. 31 FarmerEmpire Company_____
Contractor

NORTH

WEST

EAST

SOUTH

Location _____

Rig up _____

Drilling and Remarks:

1335

RECORD

Cased _____ in., _____ ft.

Sand _____

Gas _____

Oil _____

Total Depth _____

PRODUCTION

1st 24 hrs. Nat. _____

1st 24 hrs. after shot _____

Gas _____ Cu. Ft.

Dry Hole _____

Abandoned _____

Date

6/26 1918 Conding Scout

Map No. _____ Sec. 17 Twp. 28 R. 4Well No. 31 Harmer

Company _____

Contractor _____

NORTH

WEST

EAST

SOUTH

Location _____

Rig up _____

Drilling and Remarks:

1525

RECORD

Cased _____ in., _____ ft.

Sand _____

Gas _____

Oil _____

Total Depth _____

PRODUCTION

1st 24 hrs. Nat. _____

1st 24 hrs. after shot _____

Gas _____ Cu. Ft.

Dry Hole _____

Abandoned _____

Date

7/3 191 J. Cardy Scout

Map No. _____ Sec. 17 Twp. 38 R. 4
 Well No. 31 Harmer
Engine Company _____ Contractor _____

NORTH							
WEST							
SOUTH							

Location _____ Rig up _____ Drilling and Remarks: <u>2000</u>	RECORD
	Cased _____ in., _____ ft.
	Sand _____
	Gas _____
	Oil _____
	Total Depth _____
	PRODUCTION
	1st 24 hrs. Nat. _____
	1st 24 hrs. after shot _____
	Gas _____ Cu. Ft.
	Dry Hole _____
	Abandoned _____

Date

7/10 191 8 Cardiff Scout

Map No. _____ Sec. 17 Twp. 28 R. 4Well No. 31 Warner

Company _____

Contractor _____

NORTH

WEST

EAST

SOUTH

Location _____

Rig up _____

Drilling and Remarks:

RECORD

Cased _____ in., _____ ft.

Sand _____

Gas _____

Oil _____

Total Depth _____

PRODUCTION

1st 24 hrs. Nat. _____

1st 24 hrs. after shot _____

Gas _____ Cu. Ft.

Dry Hole _____

Abandoned _____

Date

2/17 1918 8 Carley Scout

Map No. _____ Sec. 17 Twp. 28 R. 4Well No. 31 former

Company _____

Contractor _____

NORTH

WEST

EAST

SOUTH

Location _____

Rig up _____

Drilling and Remarks:

RECORD

Cased _____ in., _____ ft.

Sand _____

Gas _____

Oil _____

Total Depth _____

PRODUCTION

1st 24 hrs. Nat. _____

1st 24 hrs. after shot _____

Gas _____ Cu. Ft.

Dry Hole _____

Abandoned _____

Date

2/24 191 S. C. Cady Scout

Map No. _____ Sec. 17 Twp. 28 R. 4

Well No. 31 Varner

Empire

Company

Contractor

NORTH

WEST

EAST

SOUTH

RECORD

Location _____

Cased.....in.,ft.

Rig up_____

Sand _____

Drilling and Remarks:

Gas _____

Oil _____

Total Depth.....

PRODUCTION

1st 24 hrs. Nat.

1st 24 hrs. after shot-----

Gas.....Cu. Ft.

Dry Hole.....

Abandoned.....

Date _____

7/31 1918 O. Condit Scout

Map No. _____ Sec. 17 Twp. 28 R. 4
 Well No. 31 Farmer
Empire Company
 Contractor _____

NORTH							
WEST							
SOUTH							

1240 E
 Location 1200 N

Rig up _____

Drilling and Remarks:

2403

RECORD

Cased _____ in., _____ ft.

Sand _____

Gas _____

Oil _____

Total Depth _____

PRODUCTION

1st 24 hrs. Nat. _____

1st 24 hrs. after shot _____

Gas _____ Cu. Ft.

Dry Hole _____

Abandoned _____


Date 8/7 J. C. Condy Scout
 _____ 191 _____

Map No. _____ Sec. 17 Twp. 28 R. 4Well No. 31 Varner
Empire Company
Contractor _____

NORTH

WEST

EAST

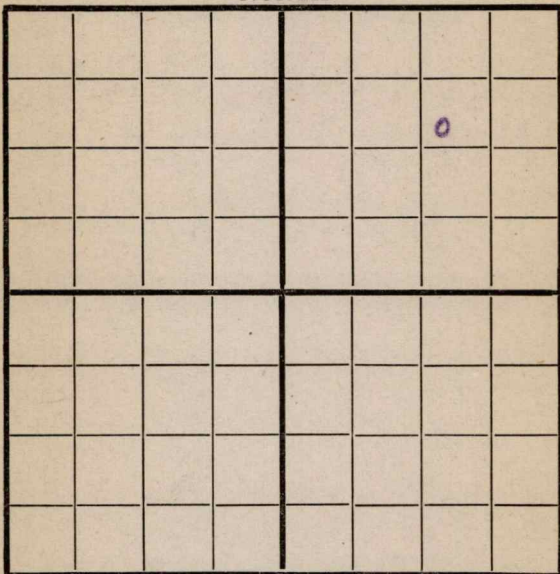

SOUTH

1240 ELocation 1200 N

Rig up _____

Drilling and Remarks:

Hall full
Oil - 25 per
order

RECORD

Cased _____ in., _____ ft.

Sand 2403-2430

Gas _____

Oil _____

Total Depth _____

PRODUCTION

1st 24 hrs. Nat. _____

1st 24 hrs. after shot _____

Gas _____ Cu. Ft.

Dry Hole _____

Abandoned _____

Date

8/14
1918

C. C. C. Scout

Map No. _____ Sec. 17 Twp. 28 R. 4

Well No. 31 Farmer


Company

Contractor

NORTH

WEST

EAST

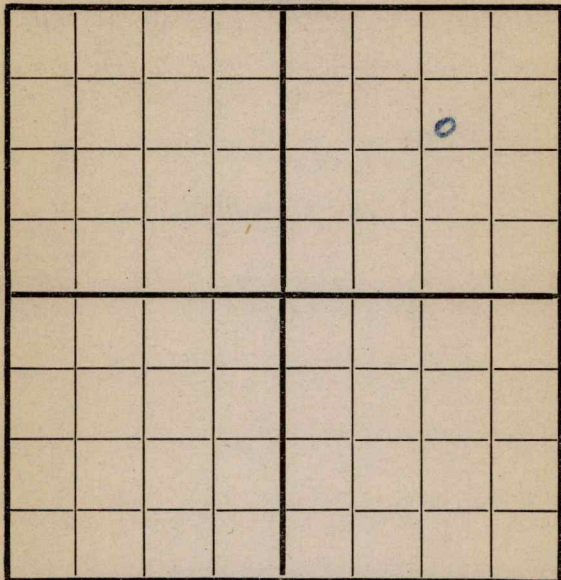

SOUTH

1200' N - 1240' E

Location _____

Rig up _____

Drilling and Remarks:

*Still in
sand with
hole full
oil -*

RECORD

Cased _____ in., _____ ft.

Sand 2403 - 2590

Gas _____

Oil _____

Total Depth _____

PRODUCTION

1st 24 hrs. Nat. _____

1st 24 hrs. after shot _____

Gas _____ Cu. Ft.

Dry Hole _____

Abandoned _____

Date

8/31 1918 Carley Scout

1002
Map No. *K11* Sec. *17* Twp. *28* R. *4*Well No. *31 Varner*

Company

Contractor

Augusta NORTH

WEST

EAST

COMPLETED

SOUTH

Location

Rig up

Drilling and Remarks:

*Est 150
Bbls. Making
Water*

RECORD

Cased _____ in., _____ ft.

Sand *2403-2430*

Gas _____

Oil _____

Total Depth *2590*

PRODUCTION

1st 24 hrs. Nat. _____

1st 24 hrs. after shot _____

Gas _____ Cu. Ft.

Dry Hole _____

Abandoned _____

Date

8/30 191 *8* *Condiff* Scout