

# KANSAS


Form 51-5M-4-36-Palace

Rush

Section 25 Township 18 Range 16-W

Well Number #2 Gisick

Company Morgan & Flynn

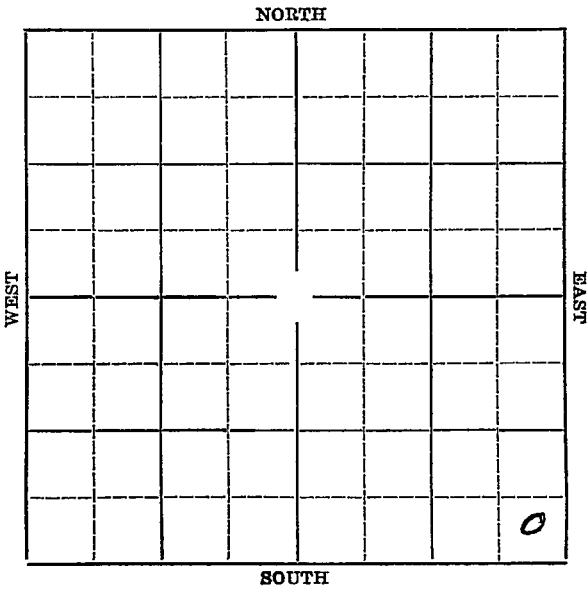

Map No. KANSAS Sec. 25 Twp. 18 R. 16W

Well No. #2 Gisiak Farm


Morgan & Flynn Company

\_\_\_\_\_ Ft. from N. Line

330' Ft. from S. Line

330' Ft. from E. Line

\_\_\_\_\_ Ft. from W. Line

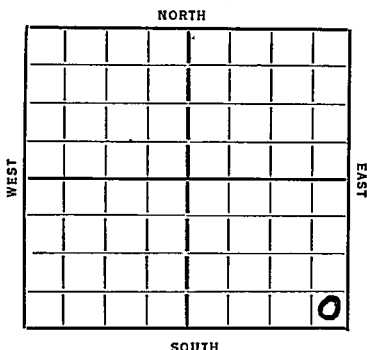

Elev. 1971

1956	REPORT
7/15	Location
7/23	Cellar.
7/30	Rig.
8/6	Rigging up.
8/13	15" @ 423'. Cleaning out.
8/20	Drlg. 825'.
8/27	Anhydrate 978'. 10" @ 985'. 1435 drilling.
9/3	Drlg. 2205'.
9/10	10" @ 2380'. Drlg. 2815'.
9/18	3255' fishing.
9/24	8" @ 3324'. Drlg. 3380'.
10/1	7" @ 3423'. TD 3523'. UR. 7".
10/8	Conglomerate 3518'. 3570' under ream 7".
10/15	-Gas 3571'. Oil 3574-86'. 2500' of oil. Drlg. 3605'.
10/22	-Basil sand 3565'. TD 3609'. Swabbed 137 oil and 37 water. Will plug back.

**OVER**

10/28/36-Basil sand 3565'.

T.D, 3619'.

Plug back to 3605'.

Pump 88 bbls.

**COMPLETED**

Map No. 74 Sec. 25 Twp. 18 R. 16W

Well No. 2 Gisick

Morgan & Flynn Company  
Contractor

**SECTION PLAT**

			0

     Ft. from N. Line

330 Ft. from S. Line

330 Ft. from E. Line

     Ft. from W. Line

**FIRST REPORT**

Location ✓

Rig up     

Drilling and Remarks:

**RECORD**

Cased      in.,      ft.

Sand     

Gas     

Oil     

Total Depth     

**PRODUCTION**

1st 24 hrs. Nat.     

1st 24 hrs. after shot     

Gas      Cu. Ft.

Dry Hole     

Abandoned     

Date

JUL 15 1936

19

S. J. LEWIS

Scout

KANSAS

Map No. 74 Sec. 25 Twp. 18 R. 16WWell No. 2 GivickMorgan & Flynn Company

Contractor

## SECTION PLAT

			0

\_\_\_\_\_ Ft. from N. Line

230 Ft. from S. Line330 Ft. from E. Line

\_\_\_\_\_ Ft. from W. Line

COMPLETED

Location \_\_\_\_\_

Rig up \_\_\_\_\_

Drilling and Remarks:

Basal Sand3565P. B3605Pump 88 88 1/2

## RECORD

Cased \_\_\_\_\_ in., \_\_\_\_\_ ft.

Sand \_\_\_\_\_

Gas \_\_\_\_\_

Oil \_\_\_\_\_

Total Depth 3619

## PRODUCTION

1st 24 hrs. Nat. \_\_\_\_\_

1st 24 hrs. after shot \_\_\_\_\_

Gas \_\_\_\_\_ Cu. Ft.

Dry Hole \_\_\_\_\_

Abandoned \_\_\_\_\_

Date

OCT 28 1936

19

S. J. LEWIS

Scout