

KANSAS

Form 51—5M—7-40—Palace


Rush

Section 25 Township 18 Range 16-W-

Well No. #3 Gisick

Company Schermerhorn

NORTH Albert Pool

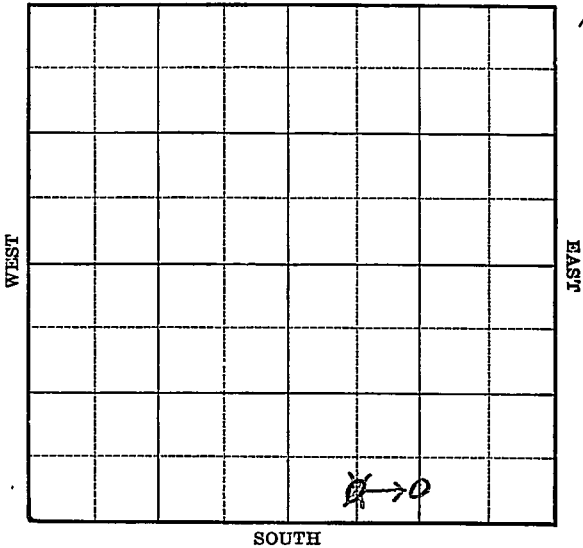

Map No. 74 Sec. 25 Twp. 18 R. 16WWell No. 3 GisickSchermerhorn

Company

~~FIRST REPORT~~

Contractor

C S L SW SE

SECTION PLAT

 Ft. from N. Line330 Ft. from S. Line Ft. from E. Line660 Ft. from W. Line

ALBERT POOL

Location Rig up

Drilling and Remarks:

12" - 235'Drlg. 632

RECORD

Cased in., ft.Sand Gas Oil Total Depth

PRODUCTION

1st 24 hrs. Nat. 1st 24 hrs. after shot Gas Cu. Ft.Dry Hole Abandoned

Date

DEC 11 1940₁₉S. J. LEWIS

Scout

Map No. 74 Sec. 25 Twp. 18 R. 16WWell No. 3 Gisick

Schermerhorn

Company

CORRECTION

Contractor

C S L SE

 Ft. from N. Line330 Ft. from S. Line1320 Ft. from E. Line Ft. from W. Line

ALBERT POOL

SECTION PLAT

Location Rig up

Drilling and Remarks:

Reported

C S L SW SE

RECORD

Cased in., ft.Sand Gas Oil Total Depth

PRODUCTION

1st 24 hrs. Nat. 1st 24 hrs. after shot Gas Cu. Ft.Dry Hole Abandoned

Date

DEC 23 1940 19S. J. LEWIS Scout

Map No. 74 Sec. 25 Twp. 18 R. 16WWell No. 3 GisickShermerhorn

Company

CORRECTION

Contractor

C S L SE

 Ft. from N. Line330 Ft. from S. Line1320 Ft. from E. Line Ft. from W. Line

ALBERT POOL

SECTION PLAT

Location Rig up

Drilling and Remarks:

Reported as*

C S L SW SE

RECORD

Cased in., ft.Sand Gas Oil Total Depth

PRODUCTION

1st 24 hrs. Nat. 1st 24 hrs. after shot Gas Cu. Ft.Dry Hole Abandoned

Date

JAN 8 1941 19S. J. LEWIS Scout

Map No. 74 Sec. 25 Twp. 18 R. 16WWell No. 3 GisickSchermerhorn

Company

~~COMPLETED~~

Contractor

C S L SE

 Ft. from N. Line330 Ft. from S. Line1320 Ft. from E. Line Ft. from W. Line

ALBERT POOL

SECTION PLAT

Location Rig up

Drilling and Remarks:

*Base 13564**5" C 3564**Pump 178 P.D.**36.5 G.U.*

RECORD

Cased in., ft.Sand Gas Oil Total Depth 3525'

PRODUCTION

1st 24 hrs. Nat. 1st 24 hrs. after shot Gas Cu. Ft.Dry Hole Abandoned

Date

JAN 15 1941 19S. J. LEWIS

Scout