

# KANSAS


FORM 51 5M BR1X

Cowley

Section 29 Township 34 Range 3E

Well No. #2 ~~Evva Collenson~~ Gas Storage

Company Ben Galapp et al

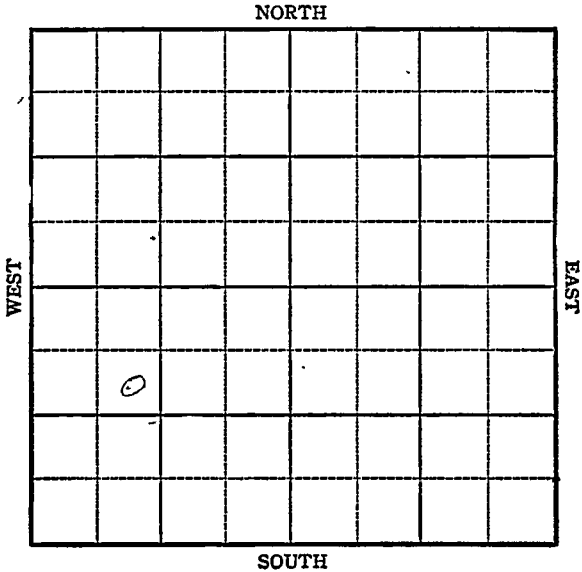

**KANSAS**

Cowley

Sec. 29 Twp. 34 R. 3E

Well No. #2 Eva Collenson Farm  
Ben Gralapp et al Company

Miscellaneous  
990'


\_\_\_\_\_ Ft. from N. Line

\_\_\_\_\_ Ft. from S. Line

\_\_\_\_\_ Ft. from E. Line

990' Ft. from W. Line

*Elev. D.F. 1151*

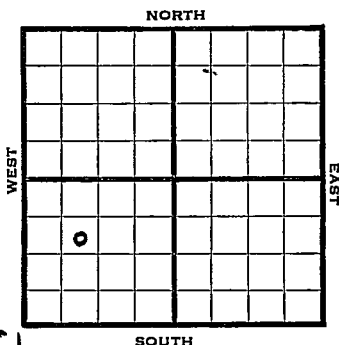

1944

REPORT

6/21	Roatary
6/28	8" @ 181 Drlg 1381
7/12	Bart 3375-95 TD Sat 34" @ 3376 RUST
7/19	" " " " " "
7/26	TD 3405 1 oil per hr
8/2	Miss 3410 TD 3420 PB 3385 8 qts. 3377-85 500 oil in 30 hrs.
8/9	20 qts 3377-85 No inc.
8/16	" " " " " "
8/23	Miss 3410 5" @ 3376 TD 3420

**ABANDONED**

**KANSAS**

Pool Name Miscellaneous

Map No.        /        Sec. 29 Twp. 34 R. 3E

Well No. 2 Eva Collenson

Ben Gralapp et al. Company

FIRST REPORT Contractor

SE NW SW

**SECTION PLAT**


990 Ft. from N. Line

       Ft. from S. Line

       Ft. from E. Line

990 Ft. from W. Line

Cowley County

Location       

Rig up       

Drilling and Remarks:

Rotary

**RECORD**

Cased        in.,        ft.

Sand       

Gas       

Oil       

Total Depth       

**PRODUCTION**

1st 24 hrs. Nat.       

1st 24 hrs. after shot       

Gas        Cu. Ft.

Dry Hole       

Abandoned       

Date

JUN 21 1944 19

S. J. LEWIS Scout

Pool Name MiscellaneousMap No. 1 Sec. 29 Twp. 34 R. 3EWell No. 2 Eva CollensonBen Gralapp et al. Company**ABANDONED**

Contractor

SE NW SW

## SECTION PLAT

990 Ft. from N. Line

\_\_\_\_\_ Ft. from S. Line

\_\_\_\_\_ Ft. from E. Line

990 Ft. from W. Line


Cowley County

## RECORD

Location \_\_\_\_\_

Cased \_\_\_\_\_ in., \_\_\_\_\_ ft.

Rig up \_\_\_\_\_

Sand \_\_\_\_\_

Drilling and Remarks:

Gas \_\_\_\_\_

Oil \_\_\_\_\_

Total Depth 3420Misc 34105" C 3376

## PRODUCTION

1st 24 hrs. Nat. \_\_\_\_\_

1st 24 hrs. after shot \_\_\_\_\_

Gas \_\_\_\_\_ Cu. Ft.

Dry Hole \_\_\_\_\_

Abandoned \_\_\_\_\_

Date \_\_\_\_\_

AUG 23 1944

19

S. J. LEWIS

Scout