

Sec. 24 Twp. 18 R. 16W

Well No. #4 Brack Farm

Aylward et al Company

Albert


 Ft. from N. Line

990 Ft. from S. Line

 Ft. from E. Line

330 Ft. from W. Line

NW SW SW

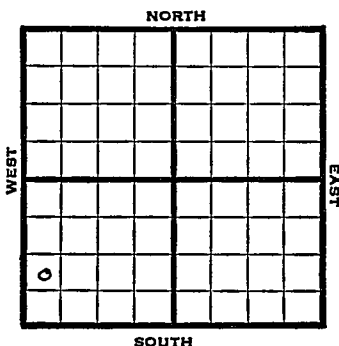

1947 Elev. 1924' REPORT

7/23 Surface hole.

7/29 8" @ 995'
Drlg. 2175'

8/6 Drlg 3474'

8/13 Basal 3487'
TD 3520'
5" @ 3520
RUST

8/20 "

8/27 TD 3522
15 qts swb 25 bbls oil a day

9/3 Basal 3487'
5" @ 3520'
Pump 10 oil / 10 W pot.
36.0 Gr.
TD 3522'

COMPLETED

Map No. _____ Sec. 24 Twp. 18 R. 16WWell No. 4 Brack

_____ Aylward etal. _____ Company

_____ FIRST REPORT _____ Contractor

NW SW SW

SECTION PLAT

_____ Ft. from N. Line

990 Ft. from S. Line

_____ Ft. from E. Line

330 Ft. from W. Line

| | | | |
|--|--|--|--|
| | | | |
| | | | |
| | | | |
| | | | |

Rush County

Location _____

Rig up _____

Drilling and Remarks:

surface hole

RECORD

Cased _____ in., _____ ft.

Sand _____

Gas _____

Oil _____

Total Depth _____

PRODUCTION

1st 24 hrs. Nat. _____

1st 24 hrs. after shot _____

Gas _____ Cu. Ft.

Dry Hole _____

Abandoned _____

Date

JUL 23 1947

19

S. J. LEWIS Scout

