


Section 24 Township 18 Range 16-W

Well Number 1 Rubart

Company Carter Oil

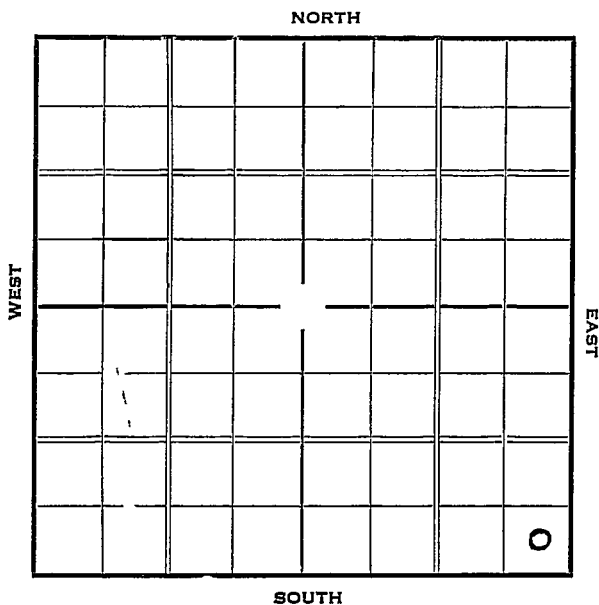

Sec. 24 Twp. 18 R. 16-W

Well No. #1 Rubart Farm

Carter Oil Company


         Ft. from N. Line

330 Ft. from S. Line

330 Ft. from E. Line

         Ft. from W. Line

Elev. 1920

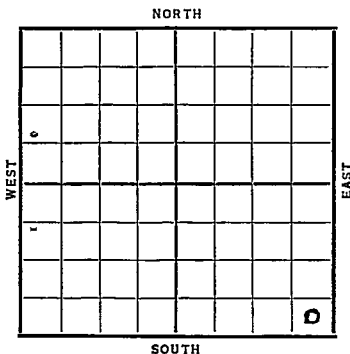

Date	REPORT
2/17	Location
2/26	ROG
3/4	Rigging up.
3/11	15" @ 226'. Drlg. 241'.
3/18	10" 930'. Drlg. 985'
3/25	Drlg. 3140'.
4/2	Sand 3482' 7" @ 3533' RUST
4/8	TD 3538' No test.
4/16	Granite 3538'. T.D. 3543'.
	Shot 50 qts. 3537-43'.
	No test.
4/23	Estimated 6 M gas.
	40 oil 40 water a day.
4/30	" " " "
5/7	" " " "
5/14	" " " "
5/21	" " " "
5/28	" " " "
6/4	" " " "
6/11	" " " "

**OVER**

1937

6/16 7" @ 3533'.

Regan 3482'.

T.D. 3543'.

65 shots 3533-38'.

50 qts. 3537-38'.

Est 40 oil.

6 M gas.

**COMPLETED**

KANSAS

Map No. 74 Sec. 24 Twp. 18 R. 16WWell No. 1 RubartCarter Oil Company

Contractor

## SECTION PLAT

			0

\_\_\_\_\_ Ft. from N. Line

330 Ft. from S. Line330 Ft. from E. Line

\_\_\_\_\_ Ft. from W. Line

## FIRST REPORT

Location ✓

Rig up \_\_\_\_\_

Drilling and Remarks:

## RECORD

Cased \_\_\_\_\_ in., \_\_\_\_\_ ft.

Sand \_\_\_\_\_

Gas \_\_\_\_\_

Oil \_\_\_\_\_

Total Depth \_\_\_\_\_

## PRODUCTION

1st 24 hrs. Nat. \_\_\_\_\_

1st 24 hrs. after shot \_\_\_\_\_

Gas \_\_\_\_\_ Cu. Ft.

Dry Hole \_\_\_\_\_

Abandoned \_\_\_\_\_

Date

FEB 17 1937 19

S. J. LEWIS Scout

Rush KANSAS

Map No. 74 Sec. 24 Twp. 18 R. 16 WWell No. 1 - RubartCarter Company

Contractor

## COMPLETED

## SECTION PLAT

			0

\_\_\_\_\_ Ft. from N. Line

330 Ft. from S. Line330 Ft. from E. Line

\_\_\_\_\_ Ft. from W. Line

Location \_\_\_\_\_

Rig up \_\_\_\_\_

Drilling and Remarks:

65 shots 3533-3850 gals 3537-38EST 40 oil6 M. gas

## RECORD

Cased 7 in., 3533 ft.Sand Regan 3482

Gas \_\_\_\_\_

Oil \_\_\_\_\_

Total Depth 3548

## PRODUCTION

1st 24 hrs. Nat. \_\_\_\_\_

1st 24 hrs. after shot \_\_\_\_\_

Gas \_\_\_\_\_ Cu. Ft.

Dry Hole \_\_\_\_\_

Abandoned \_\_\_\_\_

Date

JUN 16 1937 19 H. D. Hatfield Scout