


Section.....25.....Township.....18.....Range 16-W.....

Well Number.....1 Dirks.....

Company.....Ohio Oil.....

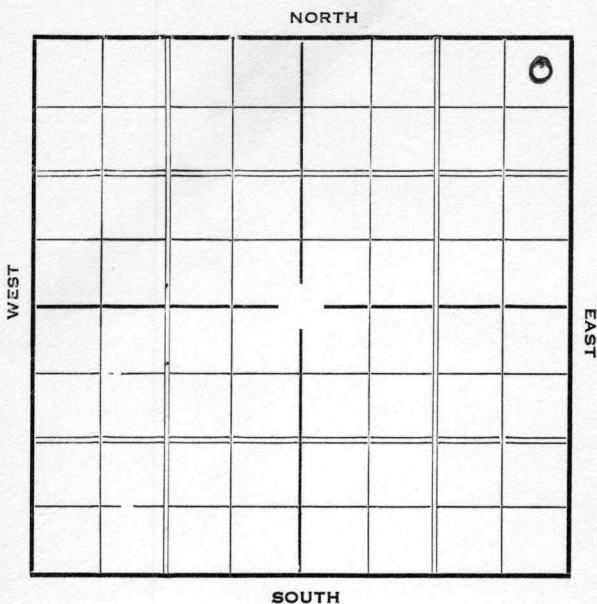

Sec. 25 Twp. 18 R. 16-W

Well No. #1 Dirks Farm


Ohio Oil Company

330 Ft. from N. Line

_____ Ft. from S. Line

330 Ft. from E. Line

_____ Ft. from W. Line

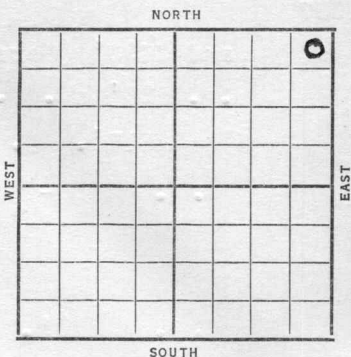

Nov. 1919

Date	REPORT
1937	
4/14	Location
4/23	R O G
4/30	"
5/7	Rig'n up cable tools.
5/14	" " " "
5/21	Spud
5/28	"
6/4	20" @ 275'. 15" @ 335'.
	Drlg. 923'.
6/11	12" @ 934'. Drlg. 1580'.
6/19	Drlg. 2180'.
6/25	10" @ 2290'. Drlg. 2390'.
7/2	Drlg. 2925'.
7/9	8" @ 3200'. Drlg. 3245'.
7/16	8" @ 3290'. T.D. 3370' H.R.
7/23	Lans. 3305'. 8" @ 3330'.
7/30	Cong. 3470'. Sand 3483-86'.
	Est. 2½ M G. Lowering 6".
	(OVER)

1937

- 8/6 Sand 3493' (Corrected) 6" @ 3493'.
T.D. 3523' sm. S.O. & 21 M. gas.
5" @ 3517'. C. O.
- 8/13 S.O. 3524-33'.
Granite wash 3555-66' T.D.
Plugging back.
- 8/20 P.B. 3522'.
- 8/28 P.B. 3517'. 60 shots. C.O.
- 9/3 1 BWPH & 600,000 gas. C.O.
- 9/10 SD.
- 9/17 Shut down.

- 9/22 Gas sand 3493'.
T.D. 3566'.
10 qts. shot.
50 qts. shot.
9 M gas.
885# R.P.

COMPLETED

Map No. _____ Sec. 25 Twp. 18 R. 16W

Well No. 1 Dicks

Ohio Oil Company

Contractor _____

SECTION PLAT

			0

330 Ft. from N. Line

_____ Ft. from S. Line

330 Ft. from E. Line

_____ Ft. from W. Line

FIRST REPORT

Location ✓

Rig up _____

Drilling and Remarks:

RECORD

Cased _____ in., _____ ft.

Sand _____

Gas _____

Oil _____

Total Depth _____

PRODUCTION

1st 24 hrs. Nat. _____

1st 24 hrs. after shot _____

Gas _____ Cu. Ft.

Dry Hole _____

Abandoned _____

Date

APR 14 1937

S. J. LEWIS Scout

Rush

Map No. 74 Sec. 25 Twp. 18 R. 16W

Well No. 1-*Ricks*

Ohio oil Company

Contractor

SECTION PLAT

			0

330 Ft. from N. Line

_____ Ft. from S. Line

330 Ft. from E. Line

_____ Ft. from W. Line

COMPLETED

Location _____

Rig up _____

Drilling and Remarks:

*10 ft. shot
50 pts "*

9 m gas

885# R.P.

RECORD

Cased _____ in., _____ ft.

Sand *Gas sand 3493*

Gas _____

Oil _____

Total Depth *3566*

PRODUCTION

1st 24 hrs. Nat. _____

1st 24 hrs. after shot _____

Gas _____ Cu. Ft.

Dry Hole _____

Abandoned _____

Date

SEP 22 1937

19

H. D. Hatfield

Scout