


Map No. KANSAS Sec. 25 Twp. 18 R. 16^w

Well No. 1- Lisick Farm
Morgan & Flynn Company

330 Ft. from N. Line
Ft. from S. Line
Ft. from E. Line
330 Ft. from W. Line

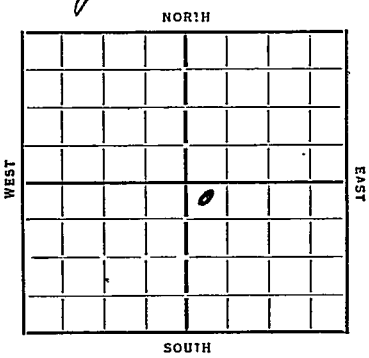

Date	REPORT
3/27	Moving In
4/4	Rig
4/11	Rgn
4/18	Spud
4/26	Dlg 480 15" 328
5/2	" 1070 17" 955
5/9	" 2400 1/4 m Gas 1890-95
5/16	10" 2358 sg 2362-65 Dlg 2500
5/23	Dlg 3125 Top 2905
5/29	K C 3225 HFW 3250-60 8" 3260 Dlg 3310
6/6	8" 3361 New 3370-80 Dlg 3470
6/13	Spud 3508 6" 3508 sg 3508-10 3518 7,900,000 Dlg 3538
6/20	T B 3543 No Gas
6/28	Shot 1/2" 3541
7/2	Spud 3508 T 3582 HFW 170 FT. ABANDONED

Map No. 74 Sec. 25 Twp. 18 R. 16W

Well No. 1 - Gish

Morgan & Flynn Company

Contractor

FIRST REPORT

SECTION PLAT

330 Ft. from N. Line

..... Ft. from S. Line

..... Ft. from E. Line

330 Ft. from W. Line

		0	

Location.....

Rig up.....

Drilling and Remarks:

Moving in

RECORD

Cased..... in., ft.

Sand.....

Gas.....

Oil.....

Total Depth.....

PRODUCTION

1st 24 hrs. Nat.....

1st 24 hrs. after shot.....

Gas..... Cu. Ft.

Dry Hole.....

Abandoned.....

Date

3-27-35 192

ORVAL MANSCHRECK

Scout

KANSAS

Form 26-1M Bks. 9-26

Map No. 74 Sec. 25 Twp. 18 R. 16W

Well No. 1- Kisick

Morgan & Polynard Company

Contractor

ABANDONED

SECTION PLAT

330 Ft. from N. Line

..... Ft. from S. Line

..... Ft. from E. Line

330 Ft. from W. Line

.		o	

Location.....

Rig up.....

Drilling and Remarks:

H F W

D & H

RECORD

Cased..... in. ft.

Sand 3508

Gas.....

Oil.....

Total Depth 3582

PRODUCTION

1st 24 hrs. Nat.....

1st 24 hrs. after shot.....

Gas..... Cu. Ft.

Dry Hole.....

Abandoned.....

Date

7-7-35 192

ORVIT, YANNSCHRECK
Scout