


Map No. _____ Sec. 17 Twp. 28 R. 4
 Well No. 14 E C Varner Farm _____
Empire Company _____

NORTH

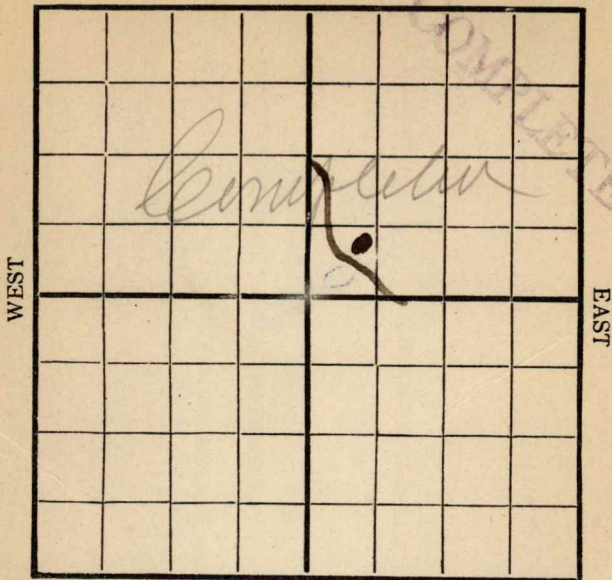

SOUTH

Location 7/3

Rig Up _____

Drilling Remarks:

Drilling Remarks:

10/2 - 2349 Top of sand
10/9 - 10/17 - 10/23 - 11/9 - 11/14

2506 ft

RECORD

PRODUCTION


Cased _____ in _____ Ft.
 Sand 2349.2399
 Gas _____
 Oil _____
 Total Depth _____

1st 24 hrs. Nat. _____
 1st 24 hrs. after shot _____
 Gas _____ Cu. Ft.
 Dry Hole _____
 Abandoned _____

Map No. _____ Sec. 17 Twp. 28 R. 4Well No. W.E.C. Farmer Farm _____Company Empire

NORTH

WEST

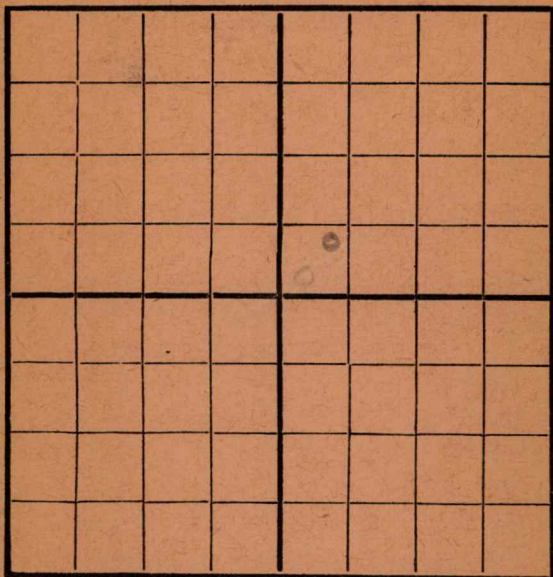

EAST

SOUTH

Location ✓

Rig Up _____

Drilling and remarks _____

RECORD

Cased _____ in. _____ Ft.

Sand _____

Gas _____

Oil _____

Total Depth _____

PRODUCTION

1st 24 hrs. Nat. _____

1st 24 hrs. after shot _____

Gas _____ Cu. Ft.

Dry Hole _____

Abandoned _____

Date

7/31916Scout Scout

Map No. _____ Sec. 17 Twp. 28 R. 4
 Well No. 148 C Homer Farm _____
Carpine Company _____

NORTH

WEST

EAST

SOUTH

Location _____
 Rig Up _____
 Drilling and remarks _____

750'

RECORD

Cased _____ in. _____ Ft.
 Sand _____
 Gas _____
 Oil _____
 Total Depth _____

PRODUCTION

1st 24 hrs. Nat. _____
 1st 24 hrs. after shot _____
 Gas _____ Cu. Ft.
 Dry Hole _____
 Abandoned _____


Date

7/15, 1916 6 R. C. O. J. Scout

Map No. _____ Sec. 17 Twp. 28 R. 4
 Well No. 14 E. Crocker Farm _____
Cummins Company _____

NORTH

WEST

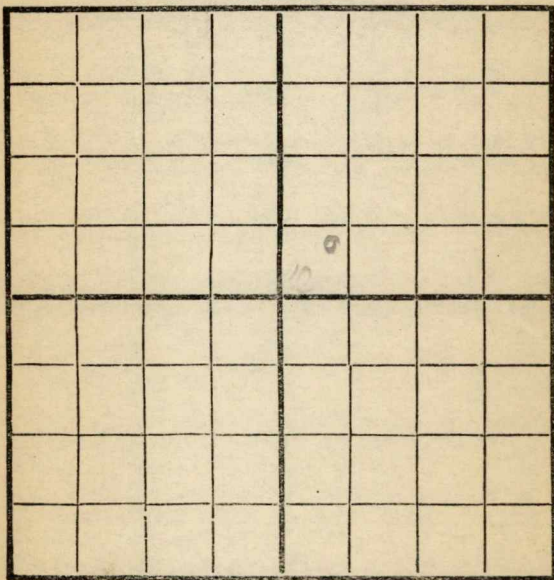

EAST

SOUTH

Location _____
 Rig Up _____
 Drilling and remarks _____

1970 = 3 1/2
gals

RECORD

Cased _____ in. _____ Ft.
 Sand _____
 Gas _____
 Oil _____
 Total Depth _____

PRODUCTION

1st 24 hrs. Nat. _____
 First 24 hrs. after shot _____
 Gas _____ Cu. Ft.
 Dry Hole _____
 Abandoned _____


Date

8/8, 1916 Scout

Map No. _____ Sec. 17 Twp. 28 R. 4
 Well No. 14 Warner Farm
Engine Company

NORTH

WEST

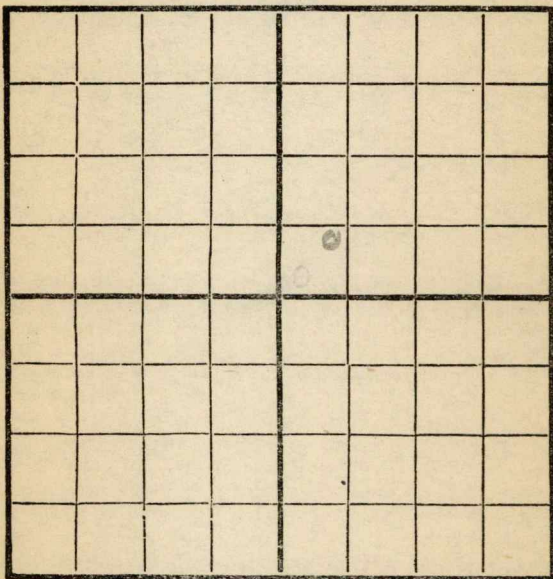

EAST

SOUTH

Location _____
 Rig Up _____
 Drilling and remarks _____

1970 Shut
down

RECORD

Cased _____ in. _____ Ft.
 Sand _____
 Gas _____
 Oil _____
 Total Depth _____

PRODUCTION


1st 24 hrs. Nat. _____
 First 24 hrs. after shot _____
 Gas _____ Cu. Ft.
 Dry Hole _____
 Abandoned _____

Date

8/18, 1916 Scout

Map No. _____ Sec. 17 Twp. 28 R. 4
Well No. 14 E C Vance Farm
Anytime Company

NORTH

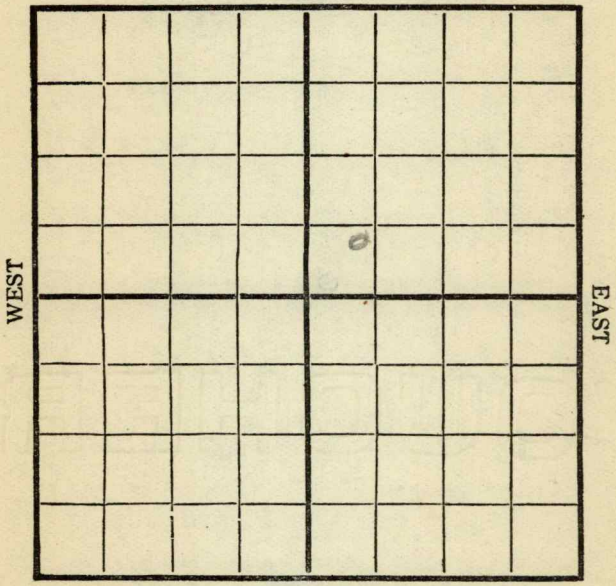

SOUTH

Location _____
Rig Up _____
Drilling and remarks _____

2100

RECORD

Cased _____ in. _____ Ft.
Sand _____
Gas _____
Oil _____
Total Depth _____

PRODUCTION

1st 24 hrs. Nat. _____
First 24 h. s. after shot _____
Gas _____ Cu. Ft.
Dry Hole _____
Abandoned _____

Date 8/21, 1916 W. C. Vance Scout

Map No. _____ Sec. 17 Twp. 38 R. 4
 Well No. 146 E. Varner Farm
Enterprise Company

NORTH

WEST

EAST

SOUTH

Location _____

Rig Up _____

Drilling and remarks

2349'
On top
sand

RECORD

Cased _____ in. _____ Ft.

Sand _____

Gas _____

Oil _____

Total Depth _____

PRODUCTION

1st 24 hrs. Nat. _____

1st 24 hrs. after shot _____

Gas _____ Cu. Ft.

Dry Hole _____


Abandoned _____

Date

AUG 30 1916
 _____, 1916

L. C. Varner Scout

Map No. _____ Sec. 17 Twp. 28 R. 4
 Well No. 14 E C Varner Farm _____
Engine Company _____
 NORTH

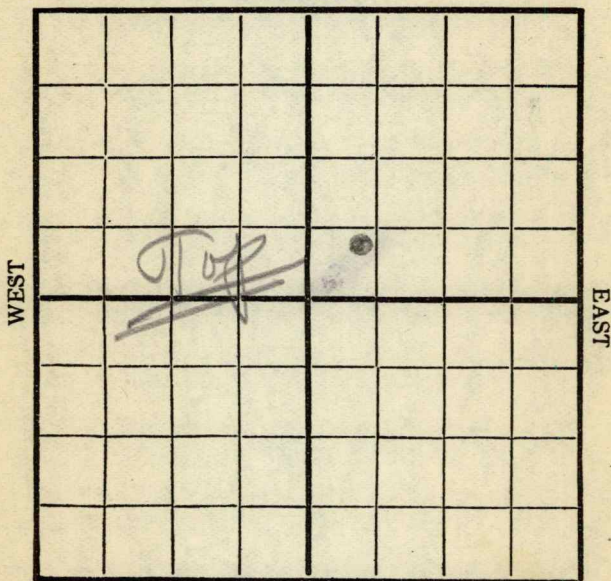

SOUTH

Location _____
 Rig Up _____
 Drilling and remarks _____

*Top sand
 Shut Down*

RECORD

Cased _____ in. _____ Ft.
 Sand 2349
 Gas _____
 Oil _____
 Total Depth _____

PRODUCTION

1st 24 hrs. Nat. _____
 1st 24 hrs. after shot _____
 Gas _____ Cu. Ft.
 Dry Hole _____
 Abandoned _____


Date 9/6, 1916 L. C. Varner Scout

Map No. _____ Sec. 17 Twp. 28 R. 4
 Well No. 14 E C Pioneer Farm _____
Enterprise Company _____

NORTH

WEST

EAST

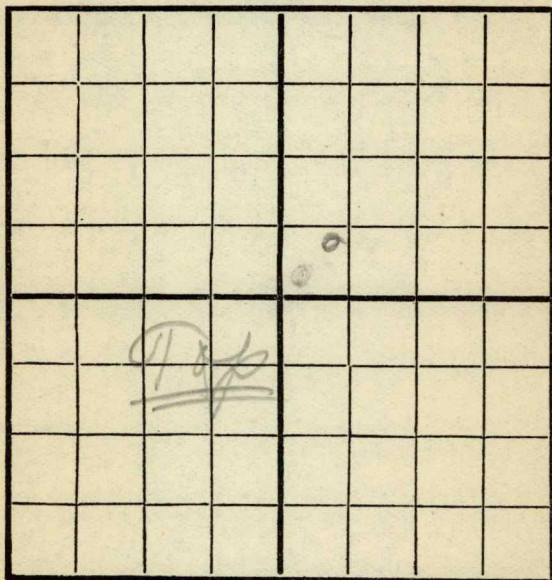

SOUTH

Location _____
 Rig Up _____
 Drilling and remarks _____

Tapsand
at 2349

RECORD


Cased _____ in. _____ Ft.
 Sand _____
 Gas _____
 Oil _____
 Total Depth _____

PRODUCTION

1st 24 hrs. Nat. _____
 1st 24 hrs. after shot _____
 Gas _____ Cu. Ft.
 Dry Hole _____
 Abandoned _____

Date 9/12, 1916 Wm. J. Scott Scout

Map No. _____ Sec. 17 Twp. 28 R. 4
 Well No. 14 E C Varner Farm _____
Empire Company _____
 NORTH

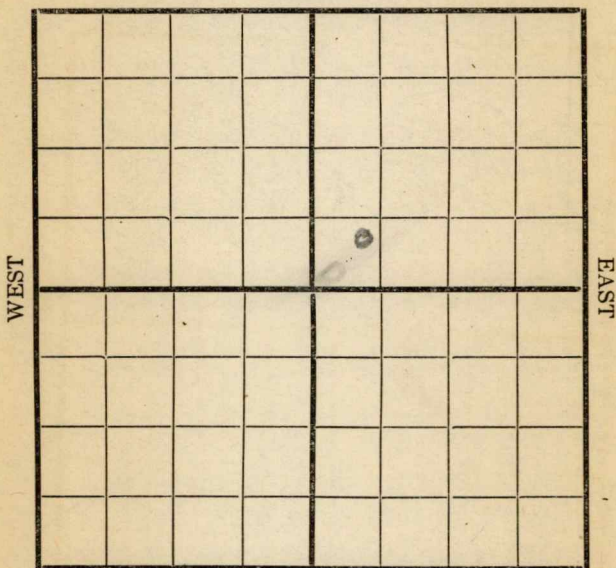

SOUTH

Location _____

Rig Up _____

Drilling and remarks

Dry sand

RECORD

Cased _____ in. _____ Ft.

Sand 2349

Gas _____

Oil _____

Total Depth _____

PRODUCTION

1st 24 hrs. Nat. _____

1st 24 hrs. after shot _____

Gas _____ Cu. Ft.

Dry Hole _____

Abandoned _____


Date

9/20, 1916 L. C. Varner Scout

Map No. _____ Sec. 17 Twp. 28 R. 4
 Well No. 14 E C Varner Farm _____
Cuyler Company _____

NORTH

WEST

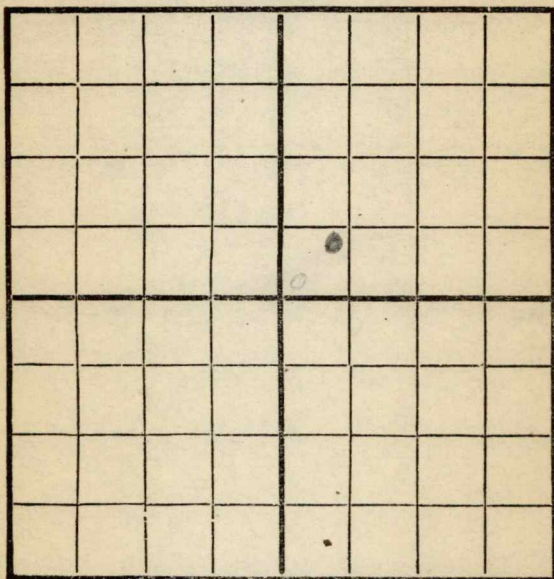

EAST

SOUTH

Location _____

Rig Up _____

Drilling and remarks _____

typ sand
2349

RECORD

Cased _____ in. _____ Ft.

Sand _____

Gas _____

Oil _____

Total Depth _____

PRODUCTION

1st 24 hrs. Nat. _____

First 24 hrs. after shot _____

Gas _____ Cu. Ft.

Dry Hole _____

Abandoned _____

Date


9/27 1916 W. C. Varner Scout

Map No. _____ Sec. 17 Twp. 28 R. 4
 Well No. 148 _____ Farm _____
Cumprine _____ Company _____

NORTH

WEST

EAST

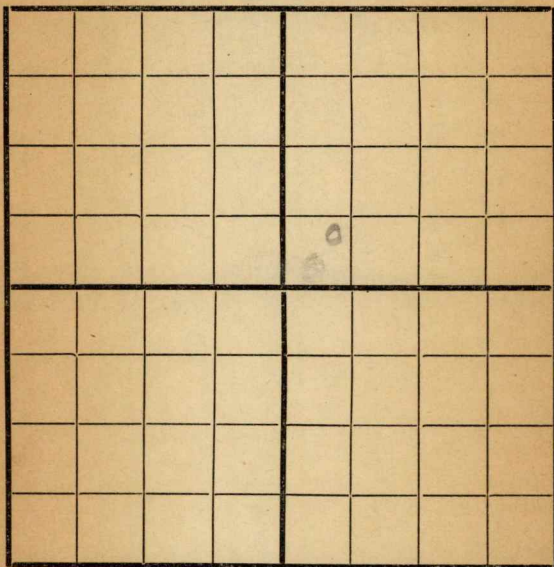

SOUTH

Location _____
 Rig Up _____
 Drilling and remarks _____

*Dry sand
 at 2349*

RECORD

Cased _____ in. _____ Ft.
 Sand _____
 Gas _____
 Oil _____
 Total Depth _____

PRODUCTION

1st 24 hrs. Nat. _____
 1st 24 hrs. after shot _____
 Gas _____ Cu. Ft.
 Dry Hole _____
 Abandoned _____

Date

10/2, 1916 Scout

Map No. _____ Sec. 12 Twp. 28 R. 4Well No. 14 Varner Farm _____Company Engine _____

NORTH

WEST

EAST

SOUTH

Location _____

Rig Up _____

Drilling and remarks

Top sand2349

RECORD

Cased _____ in. _____ Ft.

Sand _____

Gas _____

Oil _____

Total Depth _____

PRODUCTION

1st 24 hrs. Nat. _____

First 24 hrs. after shot _____

Gas _____ Cu. Ft.

Dry Hole _____


Abandoned _____

Date

10/9, 191 6 Scout

Map No. _____ Sec. 17 Twp. 28 R. 4
 Well No. 14 E C Varner Farm _____
Empire Company _____

NORTH

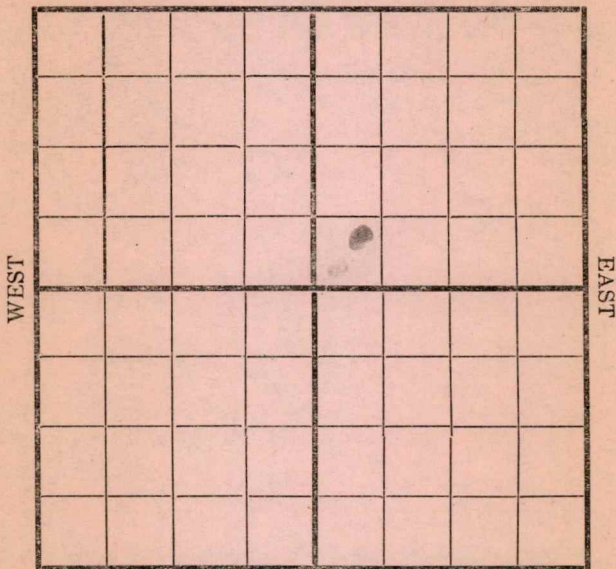

SOUTH

Location _____
 Rig Up _____
 Drilling and remarks _____

Top sand
2349

RECORD

Cased _____ in. _____ Ft.
 Sand _____
 Gas _____
 Oil _____
 Total Depth _____

PRODUCTION

1st 24 hrs. Nat. _____
 1st 24 hrs. after shot _____
 Gas _____ Cu. Ft.
 Dry Hole _____
 Abandoned _____


Date

10/17, 1916 W. Bailey Scout

Map No. _____ Sec. 17 Twp. 28 R. 4
 Well No. 1460 Farm _____
Engine Company _____

NORTH

WEST

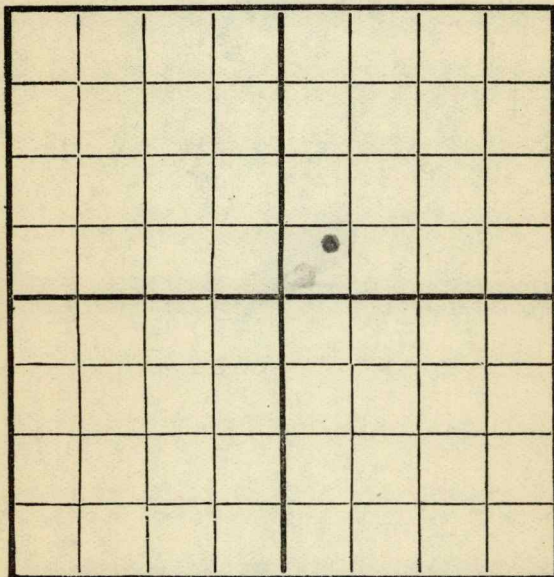

EAST

SOUTH

Location _____

Rig Up _____

Drilling and remarks _____

Pop sand
2349'

RECORD

Cased _____ in. _____ Ft.

Sand _____

Gas _____

Oil _____

Total Depth _____

PRODUCTION

1st 24 hrs. Nat. _____

First 24 h. s. after shot _____

Gas _____ Cu. Ft.

Dry Hole _____

Abandoned _____

Date


10/23/1916 _____ Scout

Map No. _____ Sec. 17 Twp. 28 R. 4

Well No. 14 E. C. Varner Farm
Engine Company

NORTH

WEST

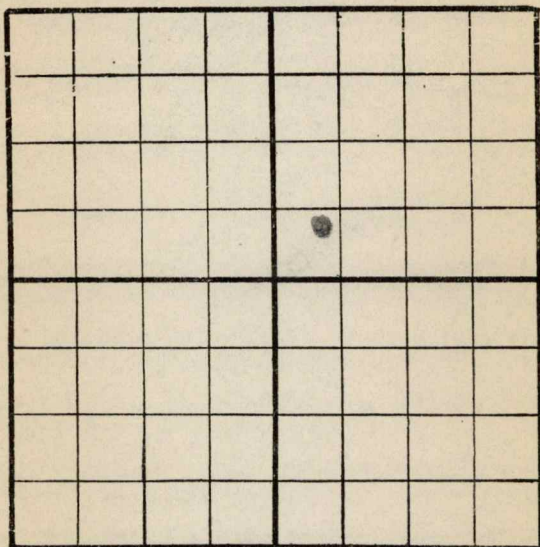

EAST

SOUTH

Location _____

Rig up _____

Drilling and remarks

Ty sand
2349'

RECORD

Cased _____ in. _____ Ft.

Sand _____

Gas _____

Oil _____

Total Depth _____

PRODUCTION

1st. 24 hrs. Nat. _____

1st 24 hrs. after shot _____

Gas _____ Cu. Ft.

Dry Hole _____

Abandoned _____

Date


10/30, 1916, Beard Scout

Map No. _____ Sec. 17 Twp. 28 R. 4
 Well No. 14 Hammer Farm _____
Empire Company _____

NORTH

WEST

EAST

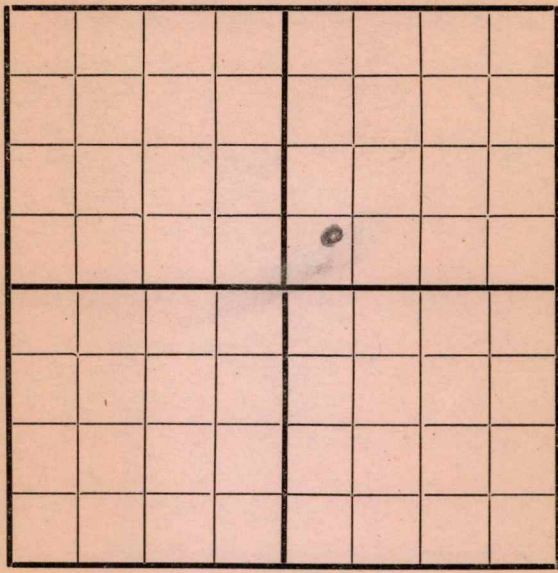


SOUTH

Location _____ Rig Up _____ Drilling and remarks <u>On top sand</u> <u>at 2349</u>	RECORD Cased _____ in. _____ Ft. Sand _____ Gas _____ Oil _____ Total Depth _____ PRODUCTION 1st 24 hrs. Nat. _____ 1st 24 hrs. after shot _____ Gas _____ Cu. Ft. Dry Hole _____ Abandoned _____
--	--

Date 4/9, 1916 6 S. C. C. C. Scout

Map No. _____ Sec. 17 Twp. 28 R. 4
 Well No. 64 EC Runner Farm _____
Engine Company _____

NORTH

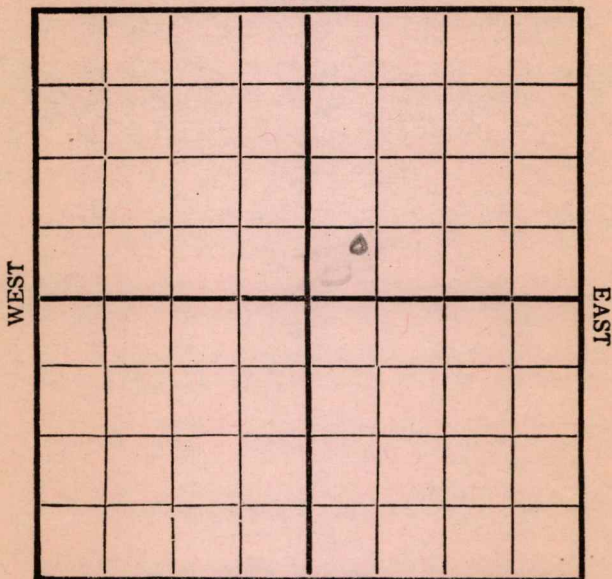

SOUTH

Location _____
 Rig Up _____
 Drilling and remarks _____

Dry sand
2349

RECORD

Cased _____ in. _____ Ft.
 Sand _____
 Gas _____
 Oil _____
 Total Depth _____


PRODUCTION

1st 24 hrs. Nat. _____
 First 24 hrs. after shot _____
 Gas _____ Cu. Ft.
 Dry Hole _____
 Abandoned _____

Date 11/14, 1916 C. C. C. C. Scout

Map No. _____ Sec. 17 Twp. 28 R. 4
 Well No. 14 E C Cramer Farm
Empire Company

NORTH

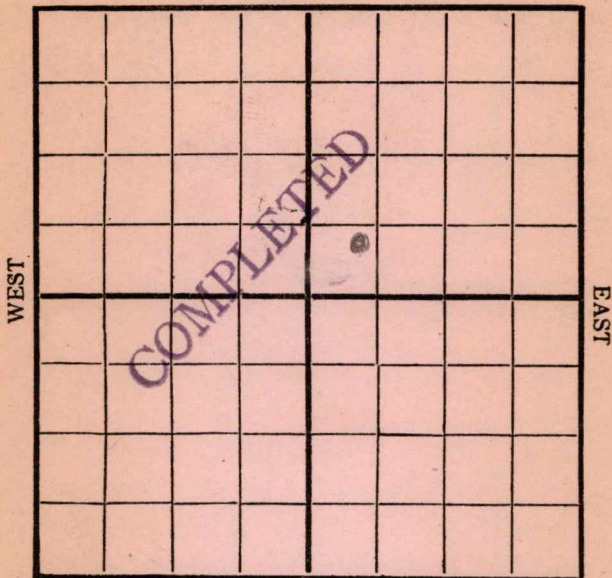

SOUTH

Location _____
 Rig Up _____
 Drilling and remarks _____

11/24
Estimated
at 250 ft

RECORD

Cased _____ in. _____ Ft.
 Sand 2349-2399
 Gas _____
 Oil _____
 Total Depth _____

PRODUCTION

1st 24 hrs. Nat. _____
 1st 24 hrs. after shot _____
 Gas _____ Cu. Ft.
 Dry Hole _____
 Abandoned _____

Date

11/30, 1916 Cramer Scout