


Rush

Section 25 Township 18 Range 16 W

Well No. # 1 Moore


Company Marmad Oil Co.

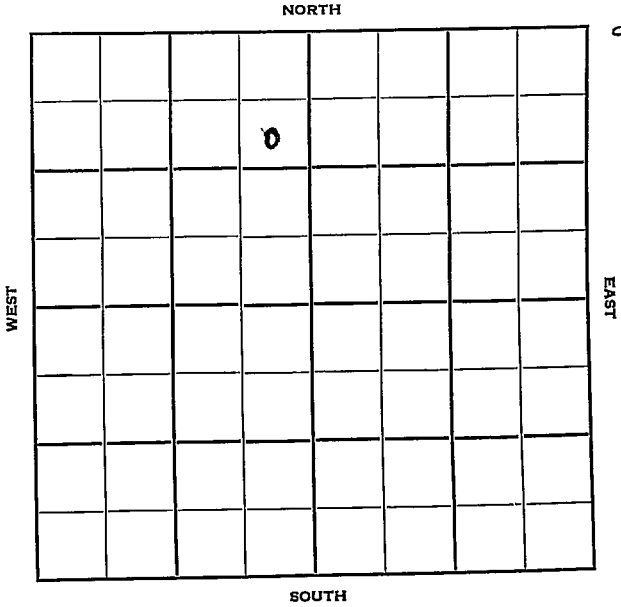

Sec. 25 Twp. 18 R. 16W

Well No. #1 Moore Farm
Marmad Oil Co. Company
Fleming & Woodman - Contr. Contractor

990' Ft. from N. Line
Ft. from S. Line
330' Ft. from E. Line
Ft. from W. Line

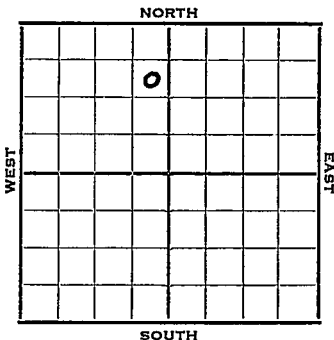

SE NE NW

1952 Elev. 1928' REPORT

8/27 MIR
9/3 8" @ 950
Anhy 944
Drlg. 3060
9/10 NR
9/17 "
9/24 Spud 8-25-52
Oil Well TD 3543' 8" @ 950
Anhy 944 Regan 3522
TD 3543' 5" @ 3527 CO to 3543
Sd-Frac Comp. 30 bopd

COMPLETED

